

MISSISSIPPI DEPARTMENT OF NATURAL RESOURCES

Bureau of Land and Water Resources

Southport Mall

P.O. Box 10631

Jackson, Mississippi 39209

WATER WELL DRILLERS LOG

Wayne  
S 98

Coded

Griner Drilling Service, Inc.

Wayne

9-20-87  
date well completed

firm name

county well located

LANDOWNER:	description of formations encountered	from	to
Chesley Pruett Drilling Co. P.O. Box 324 Laurel, Ms. 39440 (mailing address)	CLAY, SAND	0	126
WELL LOCATION: 2140'N & 2158'E sq. 24 T 7 (N) R 7 E of No. 1 Header 8 miles South of Wigginsboro 24-71 (distance) (direction) (nearest town)	SAND	126	170
WELL PURPOSE: Oilfield, no (home, irrigation, municipal, industrial) supply	CLAY, rock, lime rock	170	525
WELL COMPLETION DATA:	2140'N and 2158'E SW corner		
(1) diameter (inches) 4"			
(2) total depth (feet) 525'			
(3) static water level (feet) 45' below top of ground.			
(4) casing steel, 147' (material) (depth) 4" (size) if telescope see back.			
(5) screen 20' (length), 127' (depth to top) 4" stainless steel (size) (material)			
(6) pump 7 1/2 (HP), 90 (yield gpm) 230 volt 3 phase (type power)			
(7) electric log (yes or no)			
(organization running log)			
(8) how well bottom plugged 4" backwash valve			

RECEIVED


OCT 19 1987

Department of Natural Resources  
Bureau of Land & Water Resources

DRILLERS REMARKS:

If well telescopes please sketch and show depths.

GROUND LEVEL

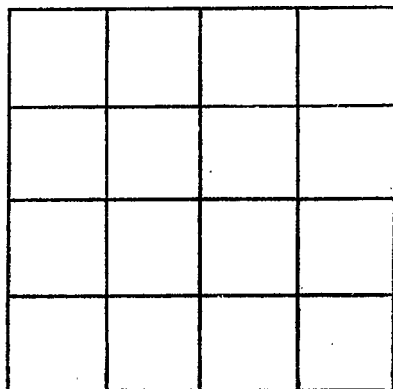

SECTION \_\_\_\_\_

Please indicate well location X.

ADDITIONAL INFORMATION

If more than one screen,  
show locations of each on sketch.