

WAYNE
S 2000
4-27-76

MISSISSIPPI
BOARD OF WATER COMMISSIONERS
416 North State Street
Jackson, Mississippi 39201

WATER WELL DRILLERS LOG

McILWAIN WATER WELL

April 27, 1976
date well completed

RT. 2, BOX 37
WAYNESBORO, MISS. 39367


Wayne
county well located

| LANDOWNER: | description of formations encountered | from | to |
|---|---------------------------------------|------|-----|
| Horace Ready At 3 Waynesboro, Miss. (mailing address) | | | |
| WELL LOCATION: sec. 33 T 7 N R 7 E 3 miles 3 of CLARA (distance) (direction) (nearest town) | Fine Sand | 10 | 18 |
| WELL PURPOSE: Home (home, irrigation, municipal, industrial) | Sand + Clay | 18 | 24 |
| WELL COMPLETION DATA: (1) diameter (inches) 2" (2) total depth (feet) 105' (3) static water level (feet) 55' below top of ground. (4) casing PVC 101 (material) (depth) 2" If telescope see back. (size) (5) screen 4' 101 (length) (depth to top) 2" PVC (size) (material) (6) pump 3/4 6 (HP) (yield gpm) 110 AC (type power) (7) electric log No (yes or no) (organization running log) (8) how well bottom plugged | Clay | 24 | 35 |
| | Blue Clay | 35 | 95 |
| | Sand & Clay | 95 | 100 |
| | Sand | 100 | 105 |
| DRILLERS REMARKS: | | | |

JUL 7 1976
MISSISSIPPI BOARD OF WATER COMMISSIONERS

If well telescopes please sketch and show depths.

GROUND LEVEL

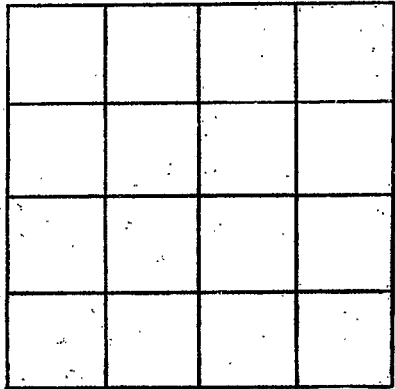

SECTION _____

Please indicate well location X.

ADDITIONAL INFORMATION

Lined area for providing additional information, consisting of approximately 25 horizontal lines.

If more than one screen, show locations of each on sketch.