

Waynes
 8 2001
 6-1-76

MISSISSIPPI
 BOARD OF WATER COMMISSIONERS
 416 North State Street
 Jackson, Mississippi 39201

WATER WELL DRILLERS LOG

June 1 1976 Porter Drilling & Log 21 Wayne
 date well completed firm name county well located

LANDOWNER: Charles Mason
 Rt 1 Buchatonna
 (mailing address)

WELL LOCATION:
 sec. 6 T 7 N R. 17 E
 5 miles S of Thayer
 (distance) (direction) (nearest town)

WELL PURPOSE: home
 (home, irrigation, municipal, industrial)

- WELL COMPLETION DATA:
- (1) diameter (inches) 2"
 - (2) total depth (feet) 73'
 - (3) static water level (feet) 37' (below above top of ground)
 - (4) casing PVC 68' (material) (depth)
 2' (size) If telescope see back.
 - (5) screen 5' 68' (length) (depth to top)
 1 1/4" split S.S. (size) (material)
 - (6) pump 1 1/2 (HP) 10 (yield gpm)
 elec (type power)
 - (7) electric log no (yes or no)

(organization running log)

(8) how well bottom plugged
 back wash valves

DRILLERS REMARKS:

description of formations encountered	from	to
Clay & sand	0	8
Clay	8	25
sand & clay	25	45
Clay & rotten logs	45	61
Thin rock		61
Clay	61	66
fine soft sand	66	72
Clay	72	74
1 1/4" split SS screen on end of cas. with back wash valve on end to shell top above 64' 1" P.V.C. drop pipe		


RECEIVED

AUG 9 - 1976

MISS. BD. OF WATER

If well telescopes please sketch and show depths.

GROUND LEVEL

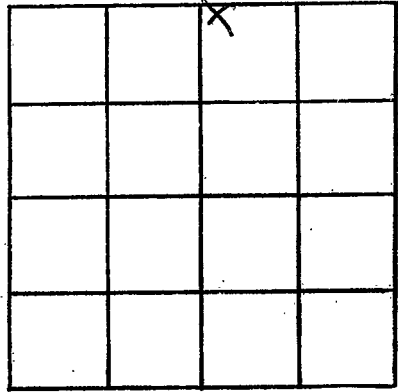

SECTION 6

Please indicate well location X.

ADDITIONAL INFORMATION

If more than one screen,
show locations of each on sketch.