

WAYNE

S 2003

8-30-78

MISSISSIPPI BOARD OF WATER COMMISSIONERS 416 North State Street Jackson, Mississippi 39201

WATER WELL DRILLERS LOG

Aug 30 1978 Porter Drilling If a gas date well completed firm name county well located

LANDOWNER: Don Williams

description of formations encountered

from to

PA 3 Cor 10.53 Magneson Miss (mailing address)

Table with 3 columns: description of formations encountered, from, to. Rows include: red clay (0-10), blue clay (10-40), clay & fine sand (40-45), clay (45-70), brown sand (70-72), clay & fine sand (72-87), fine rock (87-87), clay (87-132), fine sand (132-140), fine coarse sand (140-150), 1st water drilling, whole still in sand.

WELL LOCATION:

sec. 11 T 7 N R 7 E S W 2 miles NE of Clara (distance) (direction) (nearest town)

WELL PURPOSE: home (home, irrigation, municipal, industrial)

WELL COMPLETION DATA:


- (1) diameter (inches) 2"
(2) total depth (feet) 150
(3) static water level (feet) 6.80 below top of ground
(4) casing P.V.C. 146' (material) (depth) 2" (size) If telescope see back.
(5) screen 4' 146 (length) (depth to top) 1 1/4" 7 sch. 5 S. (size) (material)
(6) pump 1 (HP) 6 (yield gpm) elec (type power)
(7) electric log no (yes or no)

82' 1" P.V.C. large pipe

(organization running log)

(8) how well bottom plugged by back wash valve


DRILLERS REMARKS:

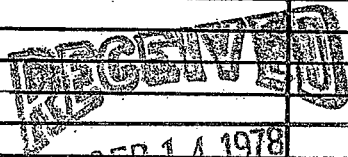

MISS. BD. OF WATER COMMISSIONERS

If well telescopes please sketch and show depths.

GROUND LEVEL

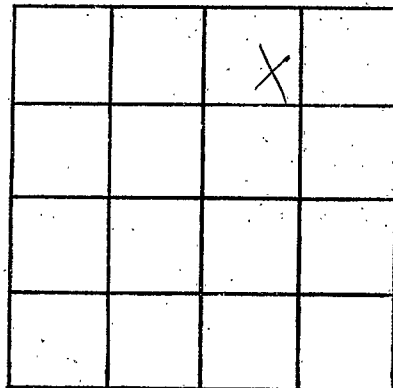

SECTION 11

Please indicate well location X.

ADDITIONAL INFORMATION

If more than one screen,
show locations of each on sketch.