

Wayne
5000
8-23-79

MISSISSIPPI
BOARD OF WATER COMMISSIONERS
416 North State Street
Jackson, Mississippi 39201

WATER WELL DRILLERS LOG

8-23
date well completed

1979

McILWAIN WATER WELL SERVICE

firm name BOX 37

county well located

WAYNESBORO MISS. 39367

LANDOWNER:	description of formations encountered	from	to
<u>Terry Jones</u>	<u>Red Sand</u>	<u>0</u>	<u>10</u>
<u>Waynesboro Miss</u> (mailing address)	<u>FINE SAND</u>	<u>10</u>	<u>30</u>
WELL LOCATION: sec. <u>4</u> T <u>7</u> N R. <u>7</u> E <u>3</u> miles <u>NE</u> of <u>CLARA</u> (distance) (direction) (nearest town)	<u>Med. FINE Yellow Sand</u>	<u>30</u>	<u>35</u>
WELL PURPOSE: <u>HOME</u> (home, irrigation, municipal, industrial)	<u>COARSE Red + White SAND</u>	<u>35</u>	<u>54</u>
WELL COMPLETION DATA: (1) diameter (inches) <u>2"</u>	<u>FINE White SAND</u>	<u>54</u>	<u>65</u>
(2) total depth (feet) <u>87'</u>	<u>Med White SAND</u>	<u>65</u>	<u>87</u>
(3) static water level (feet) <u>52'</u> below above top of ground.			
(4) casing <u>PVC</u> <u>82'</u> (material) (depth) <u>2"</u> If telescope see back. (size)			
(5) screen <u>5'</u> <u>82'</u> (length) (depth to top) <u>2"</u> <u>PVC</u> <u>008</u> (size) (material)			
(6) pump <u>1</u> <u>10</u> (HP) (yield gpm) <u>220 AC</u> (type power)			
(7) electric log <u>No</u> (yes or no)			
(organization running log)			
(8) how well bottom plugged			
DRILLERS REMARKS:			


DEPT. OF NATURAL RESOURCES
BUREAU OF LAND & WATER RESOURCES

NOV 16 1979

RECEIVED

If well telescopes please sketch and show depths.

GROUND LEVEL

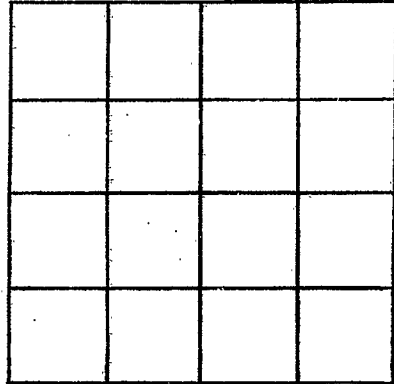

SECTION _____

Please indicate well location X.

ADDITIONAL INFORMATION

If more than one screen,
show locations of each on sketch.