

MISSISSIPPI DEPARTMENT OF NATURAL RESOURCES
Bureau of Land and Water Resources
 Southport Mall
 P.O. Box 10631
 Jackson, Mississippi 39209
WATER WELL DRILLERS LOG

Wayne
S 2000
8-21-80

Aug 21 1980 Porter Drilling & Log Wayne
 date well completed firm name county well located

LANDOWNER: James Davis
Lot 3
Waynesboro Miss
 (mailing address)

description of formations encountered	from	to
<u>clay</u>	<u>0</u>	<u>30</u>
<u>soft sand & clay</u>	<u>30</u>	<u>45</u>
<u>sand</u>	<u>45</u>	<u>60</u>

WELL LOCATION:
 sec 8 T 10N R 7E
2 miles (distance) west (direction) of Clara (nearest town)

stagnant white
stake in sand
3.5' 1" P.V.C drop pipe

WELL PURPOSE: home
 (home, irrigation, municipal, industrial)

- WELL COMPLETION DATA:
- (1) diameter (inches) 2"
 - (2) total depth (feet) 60'
 - (3) static water level (feet) 19 (below/above top of ground)
 - (4) casing P.V.C. 55'
 (material) (depth)
2" if telescope see back.
 (size)
 - (5) screen 5' 55'
 (length) (depth to top)
2" 6 slot S.S.
 (size) (material)
 - (6) pump 1 12
 (HP) (yield gpm)
elec.
 (type power)
 - (7) electric log no
 (yes or no)
- (organization running log)


(8) how well bottom plugged 2' sand slab
 DRILLERS REMARKS:

DEPT. OF NATURAL RESOURCES
 BUREAU OF LAND & WATER RESOURCES

SEP 24 1980
RECEIVED

If well telescopes please sketch and show depths.

GROUND LEVEL

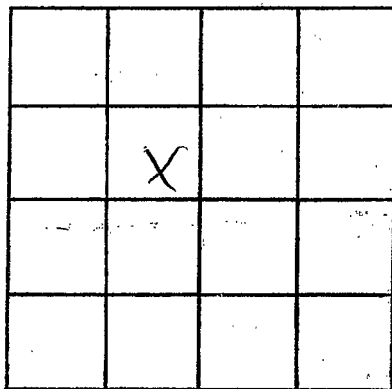

SECTION 8

Please indicate well location X.

ADDITIONAL INFORMATION

If more than one screen,
show locations of each on sketch.