

Wayne
52007

MISSISSIPPI
BOARD OF WATER COMMISSIONERS
416 North State Street
Jackson, Mississippi 39201

WATER WELL DRILLERS LOG

5-12-1982 CARRS well SERV WAYNE

date well completed

firm name

county well located

LANDOWNER: Tommy Cooley

description of formations encountered

from

to

R#1 BUCKATUNNA MS
(mailing address)

WELL LOCATION:

sec 24 T-7 N R-7 E
S W
3 1/2 miles SSE of CLARK
(distance) (direction) (nearest town)

WELL PURPOSE: HOME
(home, irrigation, municipal, industrial)

WELL COMPLETION DATA:

- (1) diameter (inches) 2"
- (2) total depth (feet) 54
- (3) static water level (feet) 15 below above top of ground.
- (4) casing PVC, 49
(material) (depth)
(size) if telescope see back.
- (5) screen 5", 49
(length) (depth to top)
2" PVC
(size) (material)
- (6) pump 1/2, 5
(HP) (yield gpm)
Elect
(type power)
- (7) electric log NO
(yes or no)

(organization running log)

(8) how well bottom plugged 3" CAP

DRILLERS REMARKS: Cut All SAND

description of formations encountered	from	to
Yellow CLAY	0	13
Fine white SAND	13	16
Yellow CLAY	16	17
Fine white SAND	17	34
Yellow CLAY	34	35
Med Yellow SD	35	43
Coarse white SAND	43	49
Med white SAND	49	53
Blue CLAY	53	54


DEPT. OF NATURAL RESOURCES
BUREAU OF LAND & WATER RESOURCES

MAY 18 1982

RECEIVED

If well telescopes please sketch and show depths.

GROUND LEVEL

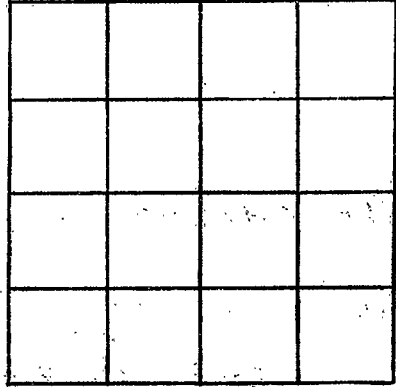

SECTION _____

Please indicate well location X.

ADDITIONAL INFORMATION

If more than one screen, show locations of each on sketch.