

MISSISSIPPI DEPARTMENT OF NATURAL RESOURCES

Bureau of Land and Water Resources

Southport Mall

P.O. Box 10631

Jackson, Mississippi 39209

WATER WELL DRILLERS LOG

Wayne  
S  
2008

Griner Drilling Service, Inc

Wayne

date well completed

firm name

county well located

LANDOWNER:

R. E. Williams  
P.O. Box 698  
Natchez, Ms. 39120  
(mailing address)

description of formations encountered

from to

<u>sand</u>	<u>0</u>	<u>20</u>
<u>clay</u>	<u>20</u>	<u>126</u>
<u>streaked</u>	<u>126</u>	<u>147</u>
<u>sand, pea gravel</u>	<u>147</u>	<u>231</u>

WELL LOCATION: 2178' S + 330' W

sec. 26 T. 7 N R. 7 E NE 1 cor

NO. 1 Clara of LOWE  
(distance) miles (direction) of (nearest town)

WELL PURPOSE: oilfield supply  
(home, irrigation, municipal, industrial)

WELL COMPLETION DATA:

- (1) diameter (inches) 3"
- (2) total depth (feet) 231'
- (3) static water level (feet) 25' below above top of ground.
- (4) casing steel, 231'  
(material) (depth)
- 3"  
(size) if telescope see back.
- (5) screen 42', 189'  
(length) (depth to top)
- 3", perforated  
(size) (material)
- (6) pump —, 70  
(HP) (yield gpm)
- AC  
(type power)
- (7) electric log —  
(yes or no)
- (organization running log)
- (8) how well bottom plugged orange  
peel


DEPT. OF NATURAL RESOURCES  
BUREAU OF LAND & WATER RESOURCES

MAY 18 1982  
RECEIVED

DRILLERS REMARKS:

If well telescopes please sketch and show depths.

GROUND LEVEL

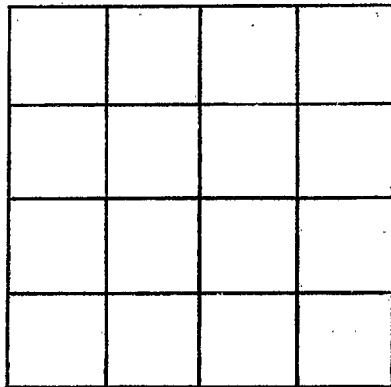

SECTION \_\_\_\_\_

Please indicate well location X.

ADDITIONAL INFORMATION

If more than one screen, show locations of each on sketch.