

MISSISSIPPI DEPARTMENT OF NATURAL RESOURCES

Bureau of Land and Water Resources

Southport Mall

P.O. Box 10631

Jackson, Mississippi 39209

WATER WELL DRILLERS LOG

Wayne
S
2009

July 16 1982 date well completed
Porter Drilling Co. firm name
Wayne county well located

LANDOWNER: Langkin Henderson
503 Dean St.
Waynesboro Miss
(mailing address)

WELL LOCATION:
sec. 25 T 7 N R 7 E
3 miles S.E. of Oara
(distance) (direction) (nearest town)

WELL PURPOSE: home
(home, irrigation, municipal, industrial)

WELL COMPLETION DATA:

- (1) diameter (inches) 2"
- (2) total depth (feet) 158'
- (3) static water level (feet) 66 (below/above top of ground)
- (4) casing P.V.C. 153'
(material) (depth)
2" (size) If telescope see back.
- (5) screen 5' 153'
(length) (depth to top)
2" 6 slit S.S.
(size) (material)
- (6) pump 3/4 4
(HP) (yield gpm)
elec. (type power)
- (7) electric log no
(yes or no)

(8) how well bottom plugged 2" sand shark

DRILLERS REMARKS:

description of formations encountered	depth	
	from	to
Clay	0	10
sandy clay	10	18
Clay	18	30
Clay & sand	30	47
thin rock		47
Clay	47	58
Clay & sand	58	65
Clay	65	91
Thin rock		91
fine sand	91	101
Clay	101	122
thin rock		122
Clay	122	145
med. sand	145	156
stopped on clay		
82' 1" P.V.C. drage		
Regul		
V.V.		


DEPT. OF NATURAL RESOURCES
BUREAU OF LAND & WATER RESOURCES

SEP - 1 1982

RECEIVED

If well telescopes please sketch and show depths.

GROUND LEVEL

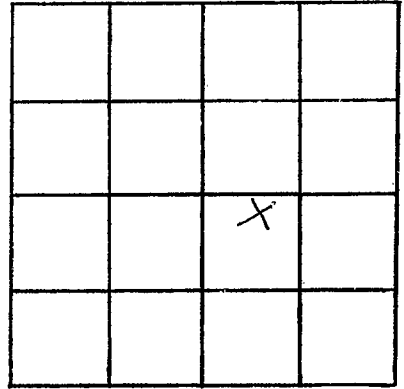

SECTION 25

Please indicate well location X.

ADDITIONAL INFORMATION

If more than one screen, show locations of each on sketch.