

MISSISSIPPI DEPARTMENT OF NATURAL RESOURCES
Bureau of Land and Water Resources
 Southport Mall
 P.O. Box 10631
 Jackson, Mississippi 39209
WATER WELL DRILLERS LOG

Wayne
5
2011

8/27 1984 CARRIS WELL SER WAYNE
 date well completed firm name county well located

LANDOWNER: JOHN MCCARY JR

description of formations encountered	from	to
TOP SOIL	0	2
YEL. SD.	2	7
BR. ROGIG	7	9
YEL. CLAY	9	25
Y. WH. SD.	25	32
YEL. CLAY	32	39
BR. A'VEL. CLAY	39	41
BLUISH CLAY	41	61
YEL. & W. "	61	74
Y. Y. WH. SD.	74	97
F. T. M. " "	97	113
MED. YEL. "	113	126
WH. CLAY	126	128

BT.1

BUCKATUNNA
 (mailing address)

WELL LOCATION:

sec. 27 7N R. 7E
S W
10 miles W of BUCK
 (distance) (direction) (nearest town)

WELL PURPOSE:

(home, irrigation, municipal, industrial)

WELL COMPLETION DATA:

- diameter (inches) 2"
- total depth (feet) 128
- static water level (feet) 56 below above top of ground.
- casing PVC, 116'
 (material) (depth)
2" if telescope see back.
 (size)
- screen 10', 116'
 (length) (depth to top)
2", P.V.C.
 (size) (material)
- pump 1 5
 (HP) (yield gpm)
ELEC.
 (type power)
- electric log NO
 (yes or no)
 (organization running log)
- how well bottom plugged CAPPED


DRILLERS REMARKS:

DEPT. OF NATURAL RESOURCES
 BUREAU OF LAND & WATER RESOURCES

SEP - 4 1984
 RECEIVED

If well telescopes please sketch and show depths.

GROUND LEVEL

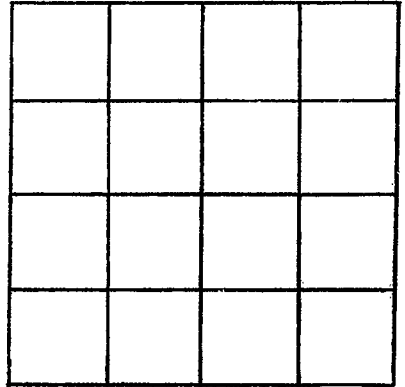

SECTION _____

Please indicate well location X.

ADDITIONAL INFORMATION

If more than one screen,
show locations of each on sketch.