

MISSISSIPPI DEPARTMENT OF NATURAL RESOURCES

Bureau of Land and Water Resources

P.O. Box 10631

Jackson, Mississippi 39209

WATER WELL DRILLERS LOG

COUNTY WELL LOCATED WAYNE	
WELL NUMBER 52003	CODED
DATE WELL COMPLETED 9/23/88	

PERMIT NUMBER 205
NAME OF DRILLING FIRM CARR'S WELL SER.
BUCKATUNGA, MS

NAME & MAILING ADDRESS OF LANDOWNER FRANK MILLER		
RT. 3		
WAYNESBORO, MS. 39367		
WELL LOCATION: SEC	TOWNSHIP	RANGE
27	7^N	7^E
DISTANCE	DIRECTION	NEAREST TOWN
3 Miles	S.E.	CLARA
OTHER LANDMARK		
WELL PURPOSE: <input checked="" type="checkbox"/> Home, <input type="checkbox"/> Irrigation, <input type="checkbox"/> Municipal, <input type="checkbox"/> Industrial, <input type="checkbox"/> Fish Pond, etc.		

PUMP DATA		
PUMP TYPE (Circle One): Submersible, Turbine, <input checked="" type="radio"/> Jet, <input type="radio"/> Flowing Well, Other (Describe) _____		
POWER TYPE (Circle One): <input checked="" type="radio"/> Electric, <input type="radio"/> Tractor, <input type="radio"/> Diesel, <input type="radio"/> Gasoline, <input type="radio"/> Butane, Other (Describe) _____ H/P 1		
Pump Capacity (GPM) 12	No. of Stages 2	Setting Depth 62 FT.
PUMP TEST		
Well yielded 20 GPM with a drawdown of 5 ft. after 1 hours of pumping		

WELL DATA		
Well Depth 247	Casing Diameter (In.) 2 1/2	Casing Length (Ft.) 142
Type of Casing PVC	Hole Depth 247	Depth to Static Water Level 50
TYPE OF COMPLETION: (Circle One or More): <input checked="" type="checkbox"/> Gravel Packed, <input type="checkbox"/> Underreamed, <input type="checkbox"/> Telescoped, <input checked="" type="checkbox"/> Natural Development, <input type="checkbox"/> Open Hole, <input type="checkbox"/> Other (Describe) _____		
Top of Lap Pipe or Reduction in Casing		
FEET	IF TELESCOPED OR MORE THAN ONE SCREEN: USE BACK PAGE	

LOG DATA	
TYPE OF LOG RUN (Circle One): No Log Run, Electric, Gamma Ray, Density, Sonic, Neutron, Other (Describe) _____	
Name of Organization Running Log	

SCREEN DATA		
Diameter - Inches 2"	Length - Feet 5'	Slot Size - Inches 6
Screen Type P.V.C.	Depth to Bottom - Feet 247	


GEOLOGIC DATA (Office Use Only)			
Surface Elev.	Gasoline Unit	Int. Thickness	Depth to Top
Subs. SW	Date	Analysis	Aquifer Test

Driller's Remarks OCT 13 1988
Department of Natural Resources Bureau of Land & Water Resources

DESCRIPTION OF FORMATIONS ENCOUNTERED	FROM	TO	FORMATIONS (Continued)	FROM	TO
TOP SD. 1	0	1	CHALK	113	141
SD. + CLAY	1	8	FINE SD.	141	144
YEL. CHALK	8	12	CHALK + ROCK	144	147
WH. "	12	20	TIGHT CHALK	147	156
BLUE "	20	24	FINE SD.	156	167
FINE SR. SAND	24	25	FIRM CHALK	167	217
GRAY CLAY	25	50	SD. + CLAY	217	222
FINE WH.	50	55	ROCK	222	223
MED. WH. SD. + CLAY	55	62	FINE SD.	223	228
CHALK	62	111	UN. TOMED. SD.	228	244
ROCK	111	113	IF MORE SPACE IS NEEDED USE BACK	244	247

If well telescopes please
sketch and show depths.

GROUND LEVEL

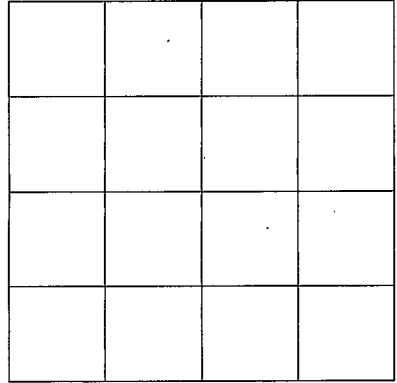

SECTION _____

Please indicate well location X.

ADDITIONAL INFORMATION

If more than one screen,
show location of each on sketch.