

MISSISSIPPI DEPARTMENT OF ENVIRONMENTAL QUALITY
Bureau of Land and Water Resources

P. O. Box 10631
Jackson, MS 39289-0631
WATER WELL DRILLERS LOG

COUNTY WELL LOCATED
Wayne

WELL NUMBER 5 CODED

DATE WELL COMPLETED
2014
9-23-93

PERMIT NUMBER

NAME OF DRILLING FIRM
A-1 Drilling Serv. Inc.
Laurel, MS.

NAME & MAILING ADDRESS OF LANDOWNER
Jerry Hutto
P.O. Box 868
Waynesboro, MS

WELL LOCATION: SEC 12 TOWNSHIP 7 RANGE 7
NW SE NE SW

DISTANCE 3 1/2 Miles E of Clara

OTHER LANDMARK

WELL PURPOSE: Home irrigation, Municipal, Industrial, Fish Pond, etc.
Blueberries

PUMP DATA

PUMP TYPE (Circle One):
Submersible Turbine, Jet, Flowing Well,
Other (Describe)

POWER TYPE (Circle One):
Electric Tractor, Diesel, Gasoline, 3 Butane,
Other (Describe) H/P 3

Pump Capacity (GPM) 45 No. of Stages 11 Setting Depth 120 FT.

PUMP TEST

Well yielded _____ GPM with
a drawdown of _____ ft.
after _____ hours of pumping

WELL DATA

Well Depth <u>150'</u>	Casing Diameter (In.) <u>4"</u>	Casing Length (Ft.) <u>140'</u>
Type of Casing <u>PVC</u>	Hole Depth <u>158'</u>	Depth to Static Water Level <u>86'</u>

TYPE OF COMPLETION: (Circle One or More):
Gravel Packed, Underreamed, Telescoped,
Natural Development, Open Hole, Other
(Describe)

Top of Lap Pipe or Reduction in Casing

FEET IF TELESCOPED OR MORE THAN ONE SCREEN: USE BACK PAGE

LOG DATA

TYPE OF LOG RUN (Circle One):
Electric, Gamma Ray, Density, Sonic, No Log Run, Neutron,
Other (Describe)

Name of Organization Running Log

SCREEN DATA

Diameter - Inches <u>4"</u>	Length - Feet <u>10'</u>	Slot Size - Inches <u>.006</u>
Screen Type <u>PVC slotted</u>	Depth to Bottom - Feet <u>150'</u>	

GEOLOGIC DATA (Office Use Only)

Surface Elev.	Geologic Unit	Unit Thickness	Depth to Top
Subs. SWL	Date	Analysis	Aquifer Test


Driller's Remarks

DESCRIPTION OF FORMATIONS ENCOUNTERED	FROM	TO	FORMATIONS (Continued)	FROM	TO
<u>Top soil</u>	<u>0</u>	<u>1</u>	<div style="font-size: 2em; font-weight: bold; opacity: 0.5;">RECEIVED</div> <div style="font-size: 1.5em; font-weight: bold; margin-top: 10px;">NOV 01 1993</div> <div style="font-size: 0.8em; margin-top: 20px;">Dept. of Environmental Quality Office of Land & Water Resources</div>		
<u>tan clay</u>	<u>1</u>	<u>9</u>			
<u>gray clay</u>	<u>9</u>	<u>65</u>			
<u>sandy clay</u>	<u>65</u>	<u>67</u>			
<u>sand</u>	<u>67</u>	<u>84</u>			
<u>clay</u>	<u>84</u>	<u>122</u>			
<u>sandy clay</u>	<u>122</u>	<u>124</u>			
<u>sand</u>	<u>124</u>	<u>152</u>			
<u>sandy clay</u>	<u>152</u>	<u>158</u>			

IF MORE SPACE IS NEEDED, USE BACK

If well telescopes please
sketch and show depths.

GROUND LEVEL

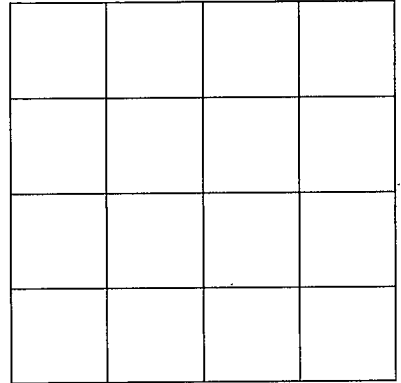

SECTION _____

Please indicate well location X.

ADDITIONAL INFORMATION

If more than one screen,
show location of each on sketch.