

T9

3-18-64

WATER WELL DRILLERS LOG

Date: March 18, 1964, Driller: Gosta Drilling & Inc County Wayne  
 (Name)

(1) Owner of Land: Robert Anderson  
 (Name)  
At 3 Waynesboro, Miss  
 (Address)  
 (2) Location: SE 1/4, SW 1/4, Sec 20 T7 R6  
6 miles west of Buckatun  
 (distance) (direction) (Nearest Town)  
 (3) Topography: Hilly  
 (Hilly) (Flat) (Level)  
 (4) Purpose of Well: domestic  
 (Domestic Irrigation  
 Municipal, Industrial, Other)


Description & Color of Materials Sand, Clay, Red Clay, Shell, etc.	Thick- ness Feet	Depth Feet
<u>sandy clay</u>	<u>8</u>	<u>8</u>
<u>chalk</u>	<u>4</u>	<u>12</u>
<u>sand</u>	<u>6</u>	<u>18</u>
<u>chalk</u>	<u>1</u>	<u>19</u>
<u>rest sand</u>	<u>2</u>	<u>21</u>
<u>blue chalk</u>	<u>30</u>	<u>51</u>
<u>soft blue chalk</u>	<u>26</u>	<u>77</u>
<u>soft &amp; chalk</u>	<u>2</u>	<u>79</u>
<u>blue chalk</u>	<u>59</u>	<u>138</u>
<u>tight fine sand</u>	<u>6</u>	<u>144</u>
<u>tight coarse red sand</u>	<u>5</u>	<u>149</u>
<u>Stopped on chalk</u>		

Information upon completion of well:

(1) Diameter 2" inches.  
 (2) Total Depth 149' feet.  
 (3) Water Level 105' feet below top of ground.  
 (4) Cased to 144', Size 2"  
 (5) Screen: Size 1 1/4", Length 5'  
10 slots S.S  
 (6) Were any formations sealed against pollution?  
no yes, X no.

If YES depth of formation \_\_\_\_\_  
 Why \_\_\_\_\_

Drillers Remarks: \_\_\_\_\_  
 \_\_\_\_\_  
 \_\_\_\_\_

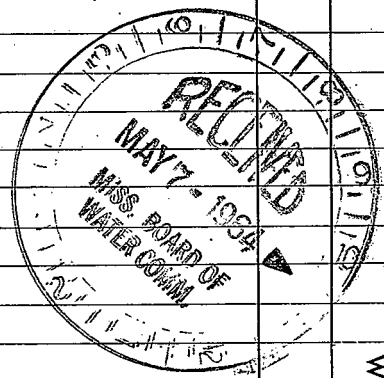

(Use Back Side)

Well No.

