

WAYNE WATER WELL DRILLERS LOG

AT 111

Date: March, 1963, Driller: Peoples Daily, County Wayne
 3-63 (Name)

(1) Owner of Land: _____
 (Name)


 (Address)
 (2) Location: 1/4, 1/4, Sec. T. R.
7 miles SE of Vernon
 (distance) (direction) (Nearest Town)
 (3) Topography: flat
 (Hilly) (Flat) (Level)
 (4) Purpose of Well: Domestic
 (Domestic Irrigation
 Municipal, Industrial, Other)

Description & Color of Materials Sand, Clay, Red Clay, Shell, etc.	Thick-ness Feet	Depth Feet
<u>Red sandy clay</u>	<u>12</u>	<u>12</u>
<u>yellow sandy clay</u>	<u>38</u>	<u>50</u>
<u>white sand</u>	<u>13</u>	<u>63</u>
<u>white sand + clay streak</u>	<u>17</u>	<u>80</u>
<u>white sand</u>	<u>35</u>	<u>115</u>

Information upon completion of well:

(1) Diameter 2 inches.
 (2) Total Depth 110 feet.
 (3) Water Level 79 feet below top of ground.
 (4) Cased to 105, Size 2"
 (5) Screen: Size 2", Length 6'
 (6) Were any formations sealed against pollution?
 _____ yes, no.

If YES depth of formation _____
 Why _____
 Drillers Remarks: _____

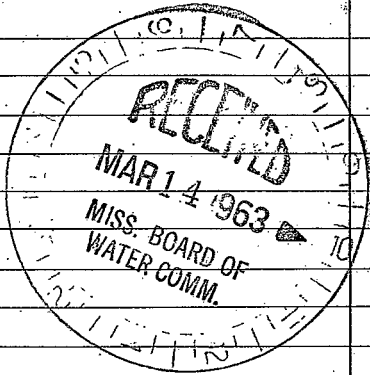

(Use Back Side)

Well No.

