

Wayne
T13
10-66

MISSISSIPPI BOARD OF WATER COMMISSIONERS

WATER WELL DRILLERS LOG


Date: Oct, 1966, Driller: People Drilling Co. County Wayne
(Name)

(1) Owner of Land: Cassie Bauman
(Name)
Rt 4 Box 100 Waynesboro
(Address)
(2) Location: SE 1/4, NW 1/4, Sec. 1 T7R6
9-10 miles SE of Waboo
(distance) (direction) (Nearest Town)
(3) Topography: Hilly
(Hilly) (Flat) (Level)
(4) Purpose of Well: Home
(Domestic Irrigation, Municipal, Industrial, Other)

Description & Color of Materials Sand, Clay, Red Clay, Shell, etc.	Thick- ness Feet	Depth Feet
<u>Red sandy clay</u>	<u>21</u>	<u>21</u>
<u>Red sand & gravel</u>	<u>19</u>	<u>40</u>
<u>White clay & sandy clay</u>	<u>61</u>	<u>101</u>
<u>Yellow sand & small clay streaks</u>	<u>25</u>	<u>126</u>

Information upon completion of well:

(1) Diameter 2 inches.
(2) Total Depth 126 feet.
(3) Water Level 81 feet below top of ground.
(4) Cased to 120', Size 2"
(5) Screen: Size 2", Length 6'
(6) Were any formations sealed against pollution?
_____ yes, ✓ no.
If YES depth of formation _____
Why _____
Drillers Remarks: _____

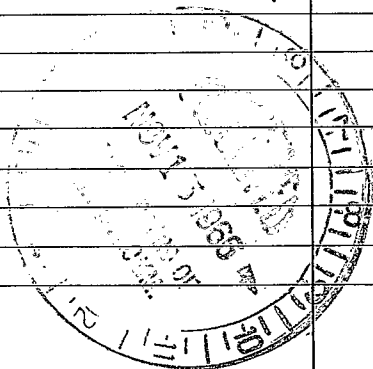

(Use Back Side)

Well No. _____

