

WAYNE MISSISSIPPI BOARD OF WATER COMMISSIONERS

T14

9-17-64

WATER WELL DRILLERS LOG

Date: Sept 17, 1964, Driller: Porter Drilling & Svc County: Wayne  
 (Name)


(1) Owner of Land: Norris Coxwell  
 (Name)  
Rt 4 Haynesboro, Miss  
 (Address)  
 (2) Location: SW 1/4, NW 1/4, Sec: 1 T7R6  
7 miles SE of Haynesboro  
 (distance) (direction) (Nearest Town)  
 (3) Topography: Hilly  
 (Hilly) (Flat) (Level)  
 (4) Purpose of Well: Domestic  
 (Domestic Irrigation  
 Municipal, Industrial, Other)

Description & Color of Materials Sand, Clay, Red Clay, Shell, etc.	Thick- ness Feet	Depth Feet
<u>red clay</u>	<u>10</u>	<u>10</u>
<u>red sand</u>	<u>22</u>	<u>32</u>
<u>chalk</u>	<u>92</u>	<u>124</u>
<u>sand</u>	<u>32</u>	<u>156</u>
<u>stop on chalk</u>		
<u>might meet coarse sand</u>		

Information upon completion of well:

(1) Diameter 2" inches.  
 (2) Total Depth 156' feet.  
 (3) Water Level 102' feet below top of ground.  
 (4) Cased to 147', Size 2"  
 (5) Screen: Size 1 1/4", Length 5'  
Johnson. S.S  
 (6) Were any formations sealed against pollution?  
 \_\_\_\_\_ yes, X no.

If YES depth of formation \_\_\_\_\_  
 Why \_\_\_\_\_  
 Drillers Remarks: \_\_\_\_\_

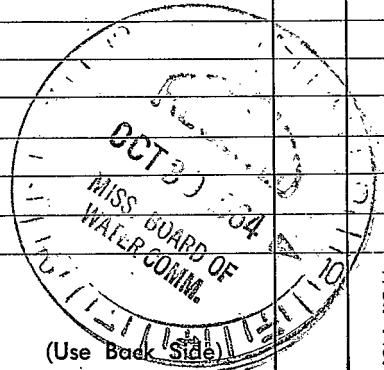

Well No. \_\_\_\_\_

(Use Back Side)

[The page contains extremely faint and illegible text, likely bleed-through from the reverse side of the document. No specific words or phrases can be discerned.]