


WAYNE  
T 16  
2-14-62

MISSISSIPPI BOARD OF WATER COMMISSIONERS

WATER WELL DRILLERS LOG

Date: Feb. 14, 1962, Driller: Porter Drilling & Sup. County Wayne  
(Name)

	Description & Color of Materials Sand, Clay, Red Clay, Shell, etc.	Thick- ness Feet	Depth Feet
(1) Owner of Land: <u>Mrs Dick Mills</u> (Name) <u>Rt 1 Buckatanna, Miss.</u> (Address)	<u>red clay &amp; sand</u>	<u>25</u>	<u>25</u>
(2) Location: <u>SE 1/4, SW 1/4, Sec. 9 T 7 R 6</u> <u>6 miles N.W.</u> , of <u>Buckatanna</u> (distance) (direction) (Nearest Town)	<u>chalk</u>	<u>5</u>	<u>30</u>
(3) Topography: <u>Hilly</u> (Hilly) (Flat) (Level)	<u>sand mixed with chalk</u>	<u>13</u>	<u>43</u>
(4) Purpose of Well: <u>Domestic</u> (Domestic Irrigation Municipal, Industrial, Other)			
Information upon completion of well:			
(1) Diameter <u>2"</u> inches.			
(2) Total Depth <u>43'</u> feet.			
(3) Water Level: <u>30</u> feet below top of ground.			
(4) Cased to <u>38'</u> , Size <u>2"</u>			
(5) Screen: Size <u>1 1/4"</u> , Length <u>5'</u>			
(6) Were any formations sealed against pollution? <u>no</u> yes, <u>X</u> no.			
If YES depth of formation _____			
Why _____			
Drillers Remarks: _____			

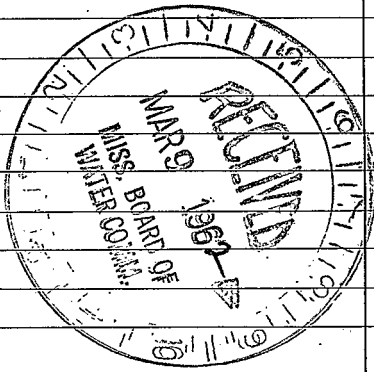

(Use Back Side)

Well No.

174