

WAYNE

Date: Oct 8, 1960, Driller: D.N. Porter & Son County Wayne

F-300

(Name)

T 17

(1) 10-8-60 Joster Mills
(Name)

Rt 1 Buckatanna, Miss
(Address)

(2) Location: 1/4, 1/4, Sec 12 T 7 R 6

4 miles NW, of Buckatanna
(distance) (direction) (Nearest Town)

(3) Topography: Level
(Hilly) (Flat) (Level)

(4) Purpose of Well: domestic
(Domestic Irrigation
Municipal, Industrial, Other)

Description & Color of Materials Sand, Clay, Red Clay, Shell, etc.	Thick- ness Feet	Depth Feet
<u>clay</u>	<u>8'</u>	<u>8'</u>
<u>sand</u>	<u>7'</u>	<u>15'</u>
<u>sand mixed with liquid chert</u>	<u>12'</u>	<u>27'</u>
<u>water would not clear up in this formation</u>		
<u>bottom on chert</u>		<u>27'</u>

Information upon completion of well:

(1) Diameter 1 1/4" inches.

(2) Total Depth 15' feet.

(3) Water Level 9' feet below top of ground.

(4) Cased to _____, Size _____

(5) Screen: Size 1 1/4", Length 4'


(6) Were any formations sealed against pollution?

_____ yes, X no.

If YES depth of formation _____

Why _____

Drillers Remarks: _____

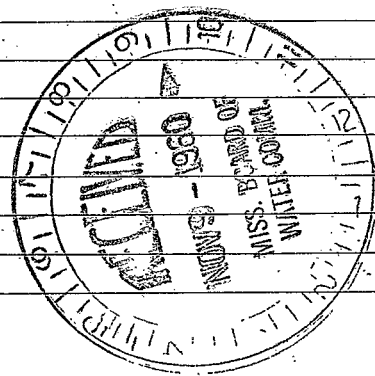

(Use Back Side)

Well No.

