

Wayne
T 18
1-68

MISSISSIPPI
BOARD OF WATER COMMISSIONERS
416 North State Street
Jackson, Mississippi 39201

WATER WELL DRILLERS LOG

Jan 22 1968 Porter Drilling & Supply Wayne
date well completed firm name county well located

LANDOWNER: W. C. Bowe

description of formations encountered from to

At 4 Waynesboro Miss
(mailing address)

red clay	0	10
fine sand	10	19
Chalk	19	46
Coarse sand	46	54

WELL LOCATION:

sec 12 T 7 (N) R 6 (E)
S W
4 miles N of Buckatunna
(distance) (direction) (nearest town)

stagnant white silt
fin sand

WELL PURPOSE: home
(home, irrigation, municipal, industrial)

WELL COMPLETION DATA:

- (1) diameter (inches) 2"
- (2) total depth (feet) 54'
- (3) static water level (feet) 30' below above top of ground.
- (4) casing steel, 48'
(material) (depth)

2"
(size) if telescope see back.

- (5) screen 5', 49'
(length) (depth to top)

1 1/4" Johnson S.S. silt
(size) (material)

- (6) pump 1/2, 7
(HP) (yield gpm)


elec
(type power)

- (7) electric log no
(yes or no)

(organization running log)


- (8) how well bottom plugged flint point

DRILLERS REMARKS:

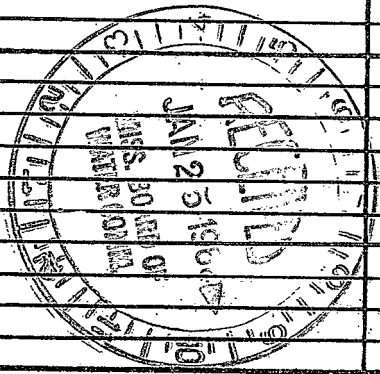

If well telescopes please sketch and show depths.

GROUND LEVEL

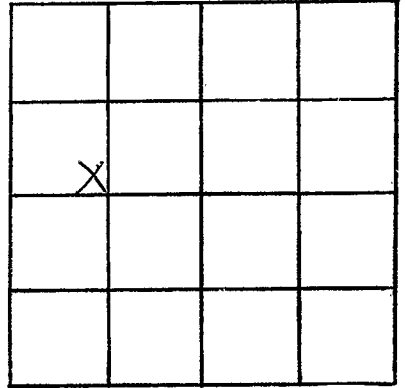

SECTION 12

Please indicate well location X.

ADDITIONAL INFORMATION

If more than one screen,
show locations of each on sketch.