

WAYNE MISSISSIPPI BOARD OF WATER COMMISSIONERS

T21  
1-30-62

WATER WELL DRILLERS LOG


Date: Jan 30, 1962, Driller: Porter Drilling & Sigs. County Wayne  
(Name)

(1) Owner of Land: <u>Dewey Mills</u> (Name)	Description & Color of Materials Sand, Clay, Red Clay, Shell, etc.	Thick- ness Feet	Depth Feet
<u>At 1 Buchatanna</u> (Address)	<u>red clay</u>	<u>20</u>	<u>20</u>
(2) Location: <u>NW 1/4, NW 1/4, Sec. 15, T7R6,</u>	<u>chalk &amp; fine sand</u>	<u>18</u>	<u>38</u>
<u>5</u> miles <u>NW</u> of <u>Buchatanna</u> (distance) (direction) (Nearest Town)	<u>course sand</u>	<u>6</u>	<u>44</u>
(3) Topography: <u>hilly</u> (Hilly) (Flat) (Level)	<u>drill on to 52' in chalk &amp; fine sand stop on chalk</u>		
(4) Purpose of Well: <u>domestic</u> (Domestic Irrigation Municipal, Industrial, Other)			

Information upon completion of well:

- (1) Diameter 2" inches.
- (2) Total Depth 44' feet.
- (3) Water Level 27' feet below top of ground.
- (4) Cased to 40', Size 2"
- (5) Screen: Size 1 1/4", Length 4'  
Johnson S.S.
- (6) Were any formations sealed against pollution?  
no

If YES depth of formation \_\_\_\_\_  
Why \_\_\_\_\_  
Drillers Remarks: \_\_\_\_\_

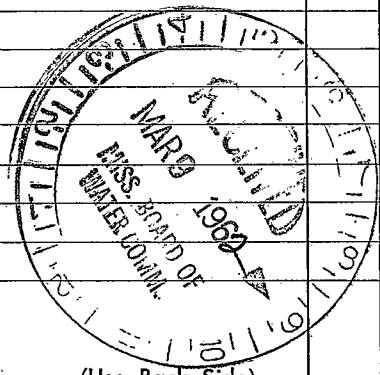

(Use Back Side)

Well No.

