

WAYNE

MISSISSIPPI BOARD OF WATER COMMISSIONERS

T22

2-24-62

WATER WELL DRILLERS LOG

Date: Feb 24, 1962, Driller: Portner & Williams, Inc. County: Wayne

(Name)

(1) Owner of Land:	Description & Color of Materials Sand, Clay, Red Clay, Shell, etc.	Thick- ness Feet	Depth Feet
Bennie Holston (Name)	stiff red clay	20	20'
Rt 1 Buckatanna, Miss. (Address)	blue chert	30	50
(2) Location: NW 1/4, NW 1/4, Sec. 15, T. 7, R. 6,	fine sand	16	66
5 miles N.W. of Buckatanna (distance) (direction) (Nearest Town)			
(3) Topography: hilly (Hilly) (Flat) (Level)			
(4) Purpose of Well: domestic (Domestic Irrigation Municipal, Industrial, Other)			

Information upon completion of well:


- (1) Diameter 2" inches.
- (2) Total Depth 66' feet.
- (3) Water Level 4.3' feet below top of ground.
- (4) Cased to 60', Size 2"
- (5) Screen: Size 1 1/4", Length 6'
80 ga.
- (6) Were any formations sealed against pollution?

yes, no.

If YES depth of formation _____

Why _____

Drillers Remarks: _____

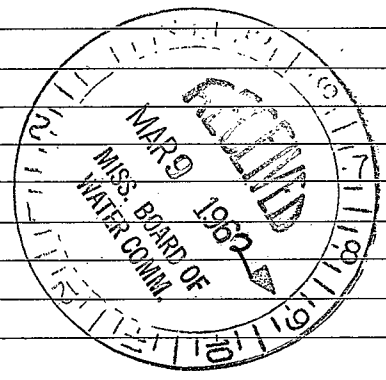

(Use Back Side)

Well No.

