

WAYNE MISSISSIPPI BOARD OF WATER COMMISSIONERS

T 23

11-13-65 WATER WELL DRILLERS LOG

Date: Nov 13, 1965, Driller: Pat Dilling Co. Wayne County Wayne

(Name)

(1) Owner of Land: A. C. Mills

(Name)

At 3 Wagonboro, Miss.

(Address)

(2) Location: SW 1/4, SW 1/4, Sec. 20 T 7 R 6

10 miles S of Wagonboro

(distance) (direction) (Nearest Town)

(3) Topography: Hilly

(Hilly) (Flat) (Level)

(4) Purpose of Well: Domestic

(Domestic Irrigation
Municipal, Industrial, Other)

Description & Color of Materials
Sand, Clay, Red Clay, Shell, etc.

Thick-
ness
Feet

Depth
Feet

<u>red clay</u>	<u>12</u>	<u>12</u>
<u>blue chalk & fine sand</u>	<u>8</u>	<u>20</u>
<u>fine sand & chalk</u>	<u>15</u>	<u>35</u>
<u>med clean sand</u>	<u>12</u>	<u>47</u>
<u>sand lignite & shells</u>	<u>5</u>	<u>52</u>
<u>stayed white</u>		
<u>stuck in fine sand</u>		

Information upon completion of well:

(1) Diameter 2" inches.

(2) Total Depth 49' feet.

(3) Water Level 24' feet below top of ground.

(4) Cased to 42', Size 2"

(5) Screen: Size 1 1/4", Length 5'


Carl Johnson S. S.

(6) Were any formations sealed against pollution?
no

If YES depth of formation _____

Why _____

Drillers Remarks: _____

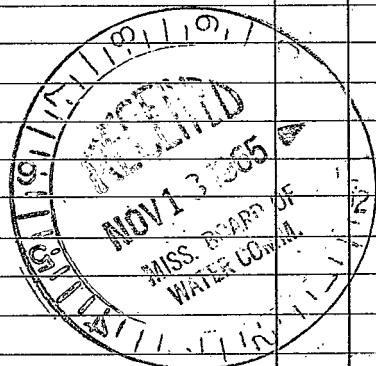

(Use Back Side)

Well No.

