

T 25

11-21-63

WATER WELL DRILLERS LOG

Date: Nov 21, 1963, Driller: Porter Drilling Co. County Wayne
 (Name)


(1) Owner of Land: James Malley
 (Name)
At 1 Buckatanna
 (Address)
 (2) Location: SW 1/4, NE 1/4, Sec. 25, T. 7 R. 6
1 miles NW of Buckatanna
 (distance) (direction) (Nearest Town)
 (3) Topography: level
 (Hilly) (Flat) (Level)
 (4) Purpose of Well: domestic
 (Domestic Irrigation
 Municipal, Industrial, Other)

Description & Color of Materials Sand, Clay, Red Clay, Shell, etc.	Thick- ness Feet	Depth Feet
<u>red clay</u>	<u>8</u>	<u>8</u>
<u>sand</u>	<u>12</u>	<u>20</u>
<u>pea gravel</u>	<u>1.5</u>	<u>35</u>
<u>med sand</u>	<u>10</u>	<u>45</u>
<u>blue sand</u>		
<u>wooded no cleanup</u>	<u>11</u>	<u>56</u>
<u>white chert</u>	<u>46</u>	<u>102</u>

Information upon completion of well:

(1) Diameter 2" inches.
 (2) Total Depth 45' feet.
 (3) Water Level 20' feet below top of ground.
 (4) Cased to 39', Size 2"
 (5) Screen: Size 1 1/4", Length 6'
 (6) Were any formations sealed against pollution?
no yes, X no.

If YES depth of formation _____
 Why _____
 Drillers Remarks: _____

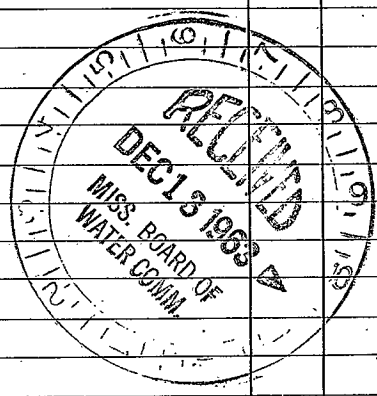

Well No.

(Use Back Side)

