

T₂₆

10-27-64

WATER WELL DRILLERS LOG

Date: Oct 27, 1964, Driller: Peter Dilling & Sons County: Wayne

(1) Owner of Land: J. J. May
 (Name)
Rt 1 Buckatanna, Miss.
 (Address)

(2) Location: NW 1/4, NE 1/4, Sec 25 T7 R6
1 miles NW of Buckatanna, Miss.
 (distance) (direction) (Nearest Town)

(3) Topography: level
 (Hilly) (Flat) (Level)

(4) Purpose of Well: domestic
 (Domestic Irrigation
 Municipal, Industrial, Other)

Description & Color of Materials Sand, Clay, Red Clay, Shell, etc.	Thick- ness Feet	Depth Feet
red clay	10	10
sand	15	25
chals	2	27
Coarse sand	2	29
fine sand & chals	6	35
ined sand	6	41
stayed white still in sand		

Information upon completion of well:

(1) Diameter 2" inches.

(2) Total Depth 41' feet.

(3) Water Level 29' feet below top of ground.

(4) Cased to 36', Size 2"


(5) Screen: Size 1 1/4", Length 4'
Johnson S.S.

(6) Were any formations sealed against pollution?
 _____ yes, X no.

If YES depth of formation _____

Why _____

Drillers Remarks: _____

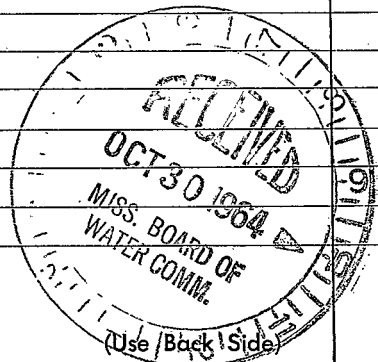

Well No.

