

Wayne  
T 27  
7-66

MISSISSIPPI BOARD OF WATER COMMISSIONERS

WATER WELL DRILLERS LOG

Date: July, 1966, Driller:  Peoples Drilling Co County Wayne  
(Name)

	Description & Color of Materials Sand, Clay, Red Clay, Shell, etc.	Thick- ness Feet	Depth Feet
(1) Owner of Land: <u>T. C. Poe</u> (Name) <u>Rt 1 Buckatanna</u> (Address)	<u>Yellow Clay</u>	<u>21</u>	<u>21</u>
(2) Location: <u>NE 1/4, NW 1/4, Sec. 27 T4N R1W</u> <u>2</u> miles <u>SE</u> of <u>Chicora</u> (distance) (direction) (Nearest Town)	<u>1) Blue Sand</u> <u>Yellow Sand</u>	<u>12</u> <u>37</u>	<u>33</u> <u>70</u>
(3) Topography: <u>Hilly</u> (Hilly) (Flat) (Level)			
(4) Purpose of Well: <u>Home</u> (Domestic Irrigation Municipal, Industrial, Other)			


Information upon completion of well:

- (1) Diameter 2 inches.
- (2) Total Depth 70 feet.
- (3) Water Level 52 feet below top of ground.
- (4) Cased to 64', Size 2"
- (5) Screen: Size 2", Length 6'
- (6) Were any formations sealed against pollution?  
no yes,  no.

If YES depth of formation \_\_\_\_\_

Why \_\_\_\_\_

Drillers Remarks: \_\_\_\_\_

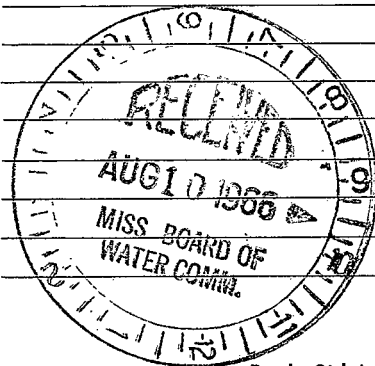

Well No.

