

Wayne  
T 28  
9-67

MISSISSIPPI  
BOARD OF WATER COMMISSIONERS  
416 North State Street  
Jackson, Mississippi 39201

WATER WELL DRILLERS LOG

Sept 2 1967 date well completed  
Dart Drilling Co firm name  
Wayne county well located

LANDOWNER: Vaughn  
Henderson

Pt. 3 Waynesboro  
(mailing address)


WELL LOCATION:  
sec. 30 T 7 N R 6 E  
10 miles S of Waynesboro  
(distance) (direction) (nearest town)

WELL PURPOSE: Home  
(home, irrigation, municipal, industrial)

WELL COMPLETION DATA:

- (1) diameter (inches) 2'
- (2) total depth (feet) 85'
- (3) static water level (feet) 37' below top of ground.
- (4) casing steel 80'  
(material) (depth)  
2' if telescope see back.  
(size)
- (5) screen 5' 80'  
(length) (depth to top)  
1/4" galv. S.S.  
(size) (material)
- (6) pump 1/2 HP 3 1/2  
(HP) (yield gpm)  
elec  
(type power)
- (7) electric log no  
(yes or no)  
(organization running log)
- (8) how well bottom plugged  
flush gravel

description of formations encountered	from	to
red clay	0	10
chalk	10	20
sand & chalk	20	80
sand	80	85
stagnant white shell in sand		

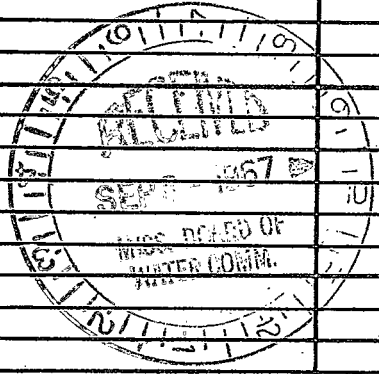

DRILLERS REMARKS:

If well telescopes please sketch and show depths.

GROUND LEVEL

X			

SECTION 30

Please indicate well location X.

ADDITIONAL INFORMATION

If more than one screen, show locations of each on sketch.