


**MISSISSIPPI
BOARD OF WATER COMMISSIONERS
416 North State Street
Jackson, Mississippi 39201**

WATER WELL DRILLERS LOG

Wayne
* T 32
8-67


Aug 9 1967 Porter Drilling & Sup Wayne
date well completed firm name county well located

LANDOWNER: <u>Eugene Mashburn</u>	description of formations encountered	from	to
<u>At 1 Buckatanna</u> (mailing address)	<u>red clay to sand</u>	0	10
WELL LOCATION: sec. <u>21</u> T. <u>7</u> N. R. <u>6</u> E. <u>4</u> miles <u>west</u> of <u>Buckatanna</u> (distance) (direction) (nearest town)	<u>sand to chalk</u>	10	40
WELL PURPOSE: <u>home</u> (home, irrigation, municipal, industrial)	<u>thin rock</u>	40	63
WELL COMPLETION DATA: (1) diameter (inches) <u>2"</u>	<u>blue chalk</u>	40	63
(2) total depth (feet) <u>139'</u>	<u>thin rock</u>	63	70
(3) static water level (feet) <u>108</u> below above top of ground.	<u>red chalk</u>	63	70
(4) casing <u>steel</u> , <u>133 1/2'</u> (material) (depth)	<u>thin rock</u>	70	70
<u>2'</u> If telescope see back. (size)	<u>blue chalk</u>	70	93
(5) screen <u>5'</u> , <u>134'</u> (length) (depth to top)	<u>sand fine to med</u>	93	114
<u>1/4"</u> , <u>7 slot S.S.</u> (size) (material)	<u>chalk</u>	114	116
(6) pump <u>1/2</u> , <u>7</u> (HP) (yield gpm)	<u>thin rock</u>	116	116
<u>elec</u> (type power)	<u>sand to chalk</u>	116	123
(7) electric log <u>no</u> (yes or no)	<u>sand</u>	123	139
(8) how well bottom plugged <u>flush point</u>	<u>stayed white shell</u>		
DRILLERS REMARKS:	<u>in sand</u>		

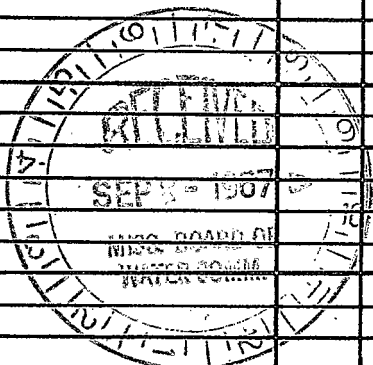

If well telescopes please sketch and show depths.

GROUND LEVEL

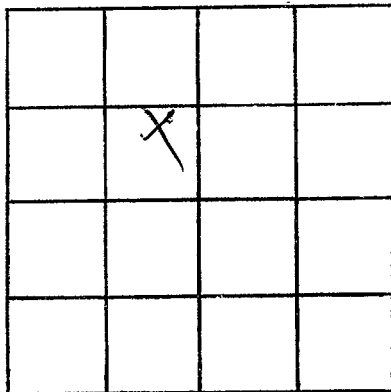

SECTION 21

Please indicate well location X.

ADDITIONAL INFORMATION

If more than one screen,
show locations of each on sketch.