

WAYNE MISSISSIPPI BOARD OF WATER COMMISSIONERS

N⁶³ T³³

7-1-64

WATER WELL DRILLERS LOG

Date: July 1, 1964, Driller: Central Drilling Inc County Wayne
 (Name)


(1) Owner of Land: <u>Edward Leverette</u> (Name)	Description & Color of Materials Sand, Clay, Red Clay, Shell, etc.	Thick- ness Feet	Depth Feet
<u>Rt 1, Buckatanna</u> (Address)	<u>red clay</u>	<u>5</u>	<u>5</u>
(2) Location: <u>SW 1/4, NW 1/4, Sec. 27 T. 7 R. 6</u>	<u>white chalk</u>	<u>22</u>	<u>27</u>
<u>5</u> miles <u>west</u> , of <u>Buckatanna</u> (distance) (direction) (Nearest Town)	<u>white sands & chalk</u>	<u>5</u>	<u>32</u>
(3) Topography: <u>hilly</u> (Hilly) (Flat) (Level)	<u>red sand</u>	<u>3</u>	<u>35</u>
(4) Purpose of Well: <u>domestic</u> (Domestic Irrigation Municipal, Industrial, Other)	<u>blue chalk</u>	<u>35</u>	<u>70</u>
	<u>fine sand</u>	<u>6</u>	<u>76</u>
	<u>blue chalk</u>	<u>11</u>	<u>87</u>
	<u>med to med coarse sand</u>	<u>22</u>	<u>109</u>

Information upon completion of well:

- (1) Diameter 2" inches.
- (2) Total Depth 109' feet.
- (3) Water Level 82' feet below top of ground.
- (4) Cased to 103, Size 2"
- (5) Screen: Size 2 1/4", Length 6'
- (6) Were any formations sealed against pollution?
 _____ yes, X no.

If YES depth of formation _____
 Why _____
 Drillers Remarks: _____

stopped with still
in sand

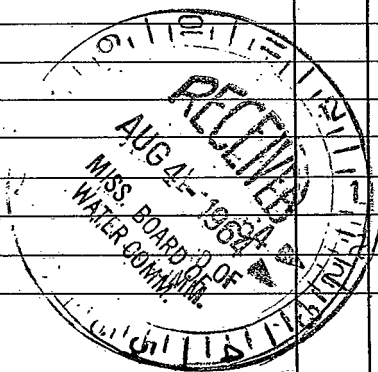

(Use Back Side)

Well No.

