

Wayne
T 37
2-69

MISSISSIPPI
BOARD OF WATER COMMISSIONERS
416 North State Street
Jackson, Mississippi 39201

CODED

WATER WELL DRILLERS LOG

2-27 1969 Laton Well Service Wayne
date well completed firm name county well located

LANDOWNER: Joe Gardner
State Line, Miss.
39362
(mailing address)

description of formations encountered	from	to
Clay	0	40
fine sand	40	60
Clay	60	125
fine sand	125	132

WELL LOCATION:
sec. 20 T 7 N R 6 E
2 miles miles W of Chicora
(distance) (direction) (nearest town)

WELL PURPOSE: home
(home, irrigation, municipal, industrial)

WELL COMPLETION DATA:

- (1) diameter (inches) 2 in.
- (2) total depth (feet) 132 ft.
- (3) static water level (feet) 95 ^{below} top of ground.
- (4) casing 2 in. 126 ft.
(material) (depth)
- _____ if telescope see back.
(size)
- (5) screen 5 ft - 80 ft. 125
(length) (depth to top)
- 2 in. Brass
(size) (material)
- (6) pump 1 1/2 5
(HP) (yield gpm)
- _____ (type power)
- (7) electric log _____
(yes or no)
- _____ (organization running log)
- (8) how well bottom plugged skinned valve

CODED


WAR 27 1969

MISS. BD. OF
WATER COM.

DRILLERS REMARKS:

If well telescopes please sketch and show depths.

GROUND LEVEL

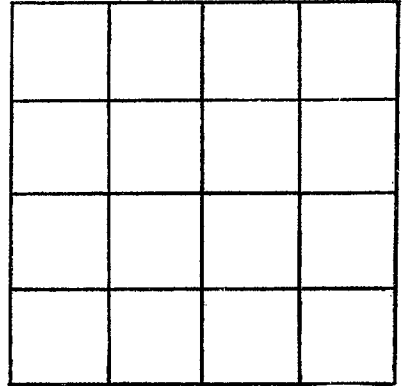

SECTION _____

Please indicate well location X.

ADDITIONAL INFORMATION

If more than one screen,
show locations of each on sketch.