

CODED

MISSISSIPPI  
BOARD OF WATER COMMISSIONERS  
416 North State Street  
Jackson, Mississippi 39201

WATER WELL DRILLERS LOG

Wayne  
T 39  
8-69

Aug 1969 Peoples Drilling Co Wayne  
date well completed firm name county well located

LANDOWNER: Jim House

description of formations encountered	from	to
Yellow Sand & gravel	0	42
White sandy clay	42	84
White sand	84	137
White Clay & Rock	137	160
White Sand & clay streak	160	210
Yellow sandy clay	210	250
Blue clay	250	273
White Sand & clay streak	273	290
Blue Clay & Rock	290	315
Gray Sand	315	340
Gray shale	340	399
lime Rock & small sand streak	399	462
Gray shale & Rock	462	588
lime Rock & sand streak	588	651
Gray shale	651	735
Green lime Rock & Black sand streak	735	840

Buckatuna, Miss  
(mailing address)

WELL LOCATION:  
sec. 25 T. 7 (N) R. 5 (E) S. 1 (W)  
1 miles N of Buckatuna  
(distance) (direction) (nearest town)

WELL PURPOSE: Chicken Farm  
(home, irrigation, municipal, industrial)

WELL COMPLETION DATA:

- (1) diameter (inches) 4
- (2) total depth (feet) 840
- (3) static water level (feet) 20 below top of ground.
- (4) casing iron, 2 9/16" (depth) 4" (size) If telescope see back.
- (5) screen 6" (length) (depth to top) 2" 5" steel (size) (material)
- (6) pump NONE (HP) (yield gpm)
- (7) electric log NO (yes or no)

(organization running log)

(8) how well bottom plugged BACK WASH VALVE


DRILLERS REMARKS:

OCT 15 1969

MISS. BD. OF WATER COMM.

If well telescopes please sketch and show depths.

GROUND LEVEL

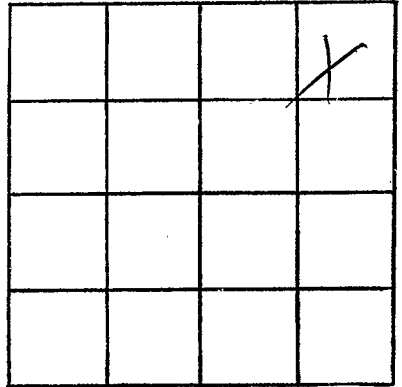

SECTION 1

Please indicate well location X.

ADDITIONAL INFORMATION

If more than one screen,  
show locations of each on sketch.