

Wayne  
T 40  
11-5-69

MISSISSIPPI  
BOARD OF WATER COMMISSIONERS  
416 North State Street  
Jackson, Mississippi 39201

CODED

WATER WELL DRILLERS LOG

Nov 5 1969 Bob Bulling & Son Wayne  
date well completed firm name county well located

| LANDOWNER: <u>Frank Lafitte</u>                 | description of formations encountered | from      | to        |
|---|---------------------------------------|-----------|-----------|
| <u>211 Buckatanna Miss</u><br>(mailing address) | <u>stiff chalk</u>                    | <u>0</u>  | <u>12</u> |
|   | <u>sand</u>                           | <u>12</u> | <u>26</u> |
|   | <u>chalk</u>                          | <u>26</u> | <u>27</u> |

WELL LOCATION:  
sec. 14 T 7 (N) R 6 E  
3 miles NW. of Buckatanna  
(distance) (direction) (nearest town)

WELL PURPOSE: drinking  
(home, irrigation, municipal, industrial)


- WELL COMPLETION DATA:
- diameter (inches) 1 1/4"
  - total depth (feet) 27'
  - static water level (feet) 19' below top of ground.
  - casing steel 21'  
(material) (depth)  
1 1/4" if telescope see back.  
(size)
  - screen 6' 21'  
(length) (depth to top)  
1 1/4" (size) plastic (material)
  - pump 1/2 8  
(HP) (yield gpm)  
elec  
(type power)
  - electric log no  
(yes or no)
- (organization running log)
- (8) how well bottom plugged: black sand

DRILLERS REMARKS:

1969  
MISS. BD. OF  
WATER COM.

If well telescopes please sketch and show depths.

GROUND LEVEL

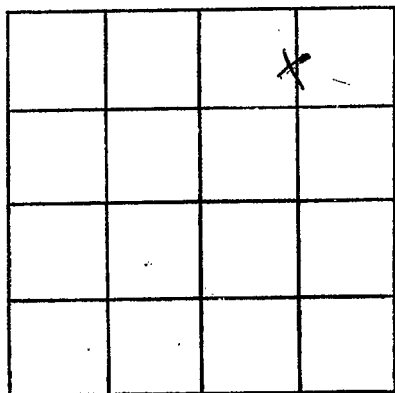

SECTION 14

Please indicate well location X.

ADDITIONAL INFORMATION

If more than one screen, show locations of each on sketch.