

Wayne
T 42
6-25-70

MISSISSIPPI
BOARD OF WATER COMMISSIONERS
416 North State Street
Jackson, Mississippi 39201

CODED

WATER WELL DRILLERS LOG

6-25 1970 CARRS well service WAYNE
date well completed firm name county well located

LANDOWNER GILBERT T. CARR

Buckatona Miss
(mailing address)

WELL LOCATION:
sec 3 T 7 S R 6 E
1/4 miles S.S.W. of BUCKATONA
(distance) (direction) (nearest town)

WELL PURPOSE: CAMP
(home, irrigation, municipal, industrial)

WELL COMPLETION DATA:

- (1) diameter (inches) 4" x 2"
- (2) total depth (feet) 180'
- (3) static water level (feet) 2' below top of ground.
- (4) casing PLASTIC, 175' (material) (depth)
(size) if telescope see back.
- (5) screen 5' 175' (length) (depth to top)
2" 8 slot PLASTIC (size) (material)
- (6) pump NO 10 (HP) (yield gpm)
None (type power)
- (7) electric log NO (yes or no)
(organization running log)

description of formations encountered	from	to
Tap soil	0	2
Red SANDY CLAY	2	15
GRAVEL	15	18
white COARSE SAND	18	24
GRAVEL	24	27
white CLAY	27	28
GRAVEL	28	30
med white SAND	30	38
white CLAY	38	40
Bluish CLAY	40	45
FINE tight white SAND	45	47
COARSE white SAND	47	51
Bluish CLAY	51	59
COARSE white SAND	59	65
Bluish CLAY	65	68
SANDY white CLAY	68	74
Bluish CLAY	74	84
Red limey CLAY	84	85
Bluish CLAY	85	88
PINK limey CLAY	88	95
Bluish CLAY	95	100
PINK CLAY	100	120
white CLAY	120	125
Red limey CLAY	125	130
white CLAY	130	152
med white SAND	152	170
COARSE white SAND	170	180
STILL IN SAME		

CODED


JUL 2 1970

DRILLERS REMARKS: shale
TRAP @ 100'

MISS. DD. OR
WATER COMMISSIONERS
WATER DIVISION

If well telescopes please sketch and show depths.

GROUND LEVEL

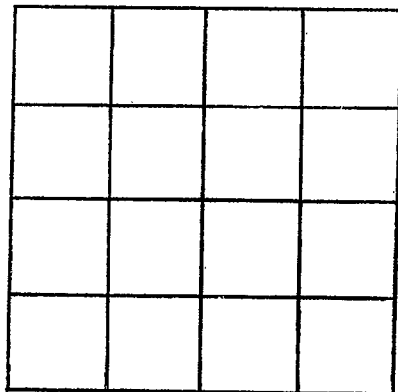

SECTION _____

Please indicate well location X.

ADDITIONAL INFORMATION

If more than one screen, show locations of each on sketch.