

WAYNE
T 44
10-26-70

MISSISSIPPI
BOARD OF WATER COMMISSIONERS
416 North State Street
Jackson, Mississippi 39201

CODED


WATER WELL DRILLERS LOG

Oct 26 1970 Bohler Drilling & Log W. Wayne
date well completed firm name county well located

LANDOWNER: <u>Frank Davis</u> <u>W. Ringham</u>	description of formations encountered	from	to
<p><u>Box 44 Hattiesburg Miss</u> (mailing address)</p>	<p><u>springy clay</u></p>	<p><u>0</u></p>	<p><u>15</u></p>
<p>WELL LOCATION: sec <u>13</u> T <u>70</u> N R <u>6</u> S <u>3</u> miles <u>N</u> of <u>Hattiesburg</u> (distance) (direction) (nearest town)</p>	<p><u>water</u></p>	<p><u>15</u></p>	<p><u>30</u></p>
<p>WELL PURPOSE: <u>home</u> (home, irrigation, municipal, industrial)</p>	<p><u>top of water table</u></p>	<p><u>30</u></p>	<p><u>38</u></p>
<p>WELL COMPLETION DATA: (1) diameter (inches) <u>2"</u> (2) total depth (feet) <u>107</u> (3) static water level (feet) <u>62</u> below top of ground. (4) casing <u>steel</u> <u>105</u> (material) (depth) <u>2"</u> (size) if telescope see back. (5) screen <u>4 1/2</u> <u>104 1/2</u> (length) (depth to top) <u>1 1/2</u> <u>20 ga SS.</u> (size) (material) (6) pump <u>1</u> <u>10</u> (HP) (yield gpm) <u>elec.</u> (type power) (7) electric log <u>no</u> (yes or no) (organization running log) (8) how well bottom plugged <u>blank</u></p>	<p><u>chert</u></p>	<p><u>38</u></p>	<p><u>63</u></p>
<p>DRILLERS REMARKS:</p>	<p><u>fine sand</u></p>	<p><u>63</u></p>	<p><u>70</u></p>
	<p><u>chert shale</u></p>	<p><u>70</u></p>	<p><u>76</u></p>
	<p><u>stagnant on chert</u></p>	<p><u>76</u></p>	<p><u>107</u></p>
	<p><u>11 1/2" 80 ga SS. test</u></p>		
	<p><u>in north pocket</u></p>		
	<p><u>75 1/2" 10" 20 ga SS. pipe</u></p>		
	<p><u>U U U</u></p>		
	<p>CODED</p>		
	<p>NOV 16 1970</p>		
	<p>MISS. BD. OF WATER COMM.</p>		

If well telescopes please sketch and show depths.

GROUND LEVEL

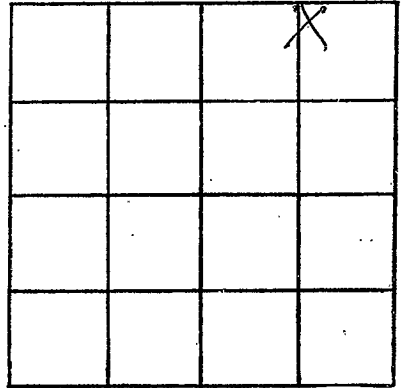

SECTION 13

Please indicate well location X.

ADDITIONAL INFORMATION

If more than one screen,
show locations of each on sketch.