

WAYNE
T45
3-22-71

MISSISSIPPI
BOARD OF WATER COMMISSIONERS
416 North State Street
Jackson, Mississippi 39201

CODED

WATER WELL DRILLERS LOG

Mar 22 1971 Roy West Water Wells Wayne
date well completed firm name county well located

LANDOWNER: MacPowe
Bucatura Rt 1
(mailing address)

description of formations encountered	from	to
sandy clay	0	15
clay	15	35
sand	35	42
clay	42	130
sand	130	140
clay	140	162
sand	162	172

WELL LOCATION:
sec. 35 T 20 N R 6 E
5 miles E of Bucatura
(distance) (direction) (nearest town)

WELL PURPOSE: home
(home, irrigation, municipal, industrial)

- WELL COMPLETION DATA:
- (1) diameter (inches) 2 in
 - (2) total depth (feet) 172
 - (3) static water level (feet) 75 below top of ground.
 - (4) casing plastic 167 (material) (depth)
 - (size) if telescope see back.
 - (5) screen 5 167 (length) (depth to top)
 - 1/4 St. Steel (size) (material)
 - (6) pump 1/2 8 (HP) (yield gpm)
 - RE-A (type power)
 - (7) electric log No (yes or no)
 - (organization running log)
 - (8) how well bottom plugged coarse

CODED


MAR 30 1971

DRILLERS REMARKS:

MISS. BD. OF
WATER COM.

If well telescopes please sketch and show depths.

GROUND LEVEL

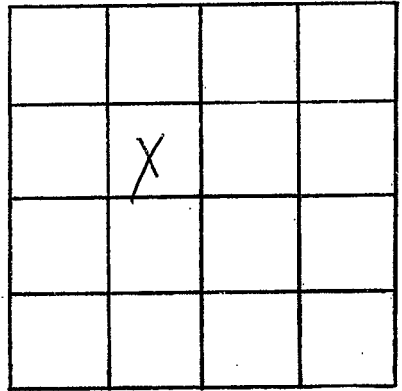

SECTION 35

Please indicate well location X.

ADDITIONAL INFORMATION

If more than one screen, show locations of each on sketch.