

WAYNE  
T 46  
4-6-71

MISSISSIPPI  
BOARD OF WATER COMMISSIONERS  
416 North State Street  
Jackson, Mississippi 39201

**CODED**

WATER WELL DRILLERS LOG

April 6 1971 Boots-Drillers & Log Wayne  
(date well completed) (firm name) (county well located)

LANDOWNER: Mrs Earnest Mc Carthy  
At 1 Buckatanna Miss  
(mailing address)

WELL LOCATION:  
sec. 15 T 7 N R 6 E  
2 1/2 miles NW of Buckatanna  
(distance) (direction) (nearest town)

WELL PURPOSE: Home  
(home, irrigation, municipal, industrial)

- WELL COMPLETION DATA:
- (1) diameter (inches) 2
  - (2) total depth (feet) 154
  - (3) static water level (feet) 88 below top of ground
  - (4) casing steel 125'  
(material) (depth)  
2" if telescope see back.  
(size)
  - (5) screen 5' 129'  
1/4" (length) (depth to top)  
shot 3.5  
(size) (material)
  - (6) pump elec 1/2  
(HP) (yield gpm)  
(type power)
  - (7) electric log no  
(yes or no)  
(organization running log)
  - (8) how well bottom plugged shot cement

description of formations encountered	from	to
red clay	0	8
sand	8	24
Chalk	24	30
sand	30	44
thin rock		44
blue Chalk	44	59
rock	59	60
Chalk	60	105
fine red sand	105	125
red sand	125	154
slight white clay		
with cement		
5' 1/4" shot 3.5		
4' 1/4" log pipe		
in well packer		
105' 1/4" drop pipe		


**CODED**

MAY 6 - 1971

DRILLERS REMARKS:

If well telescopes please sketch and show depths.

GROUND LEVEL

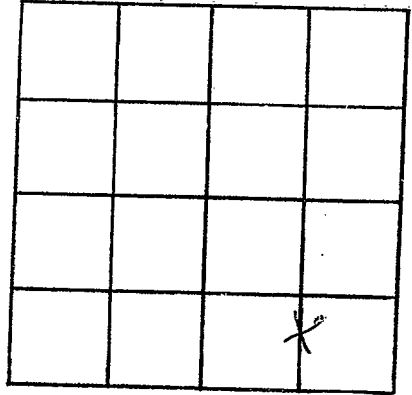

SECTION 15

Please indicate well location X.

ADDITIONAL INFORMATION

If more than one screen,  
show locations of each on sketch.