

WAYNE  
T47  
4-23-71

MISSISSIPPI  
BOARD OF WATER COMMISSIONERS  
416 North State Street  
Jackson, Mississippi 39201

WATER WELL DRILLERS LOG

**CODED**

April 23 1971  
date well completed

71 Buck Drilling Log  
firm name

Wayne  
county well located

LANDOWNER: Gene Washburn  
At 1 Buckaterra Miss  
(mailing address)

description of formations encountered	from	to
clay	0	5
sand	5	13
sand to soft chalk	18	27
chalk	27	34
rock	34	36
chalk	36	46
me. sand from	46	55
loose sand some chalk	55	58
stagnant white silt		
in loose sand & chalk		

WELL LOCATION:  
sec. 22 T. 70 N R. 6 E  
S (W)  
3.2 miles NW of Buckaterra  
(distance) (direction) (nearest town)

WELL PURPOSE: Home  
(home, irrigation, municipal, industrial)

- WELL COMPLETION DATA:
- (1) diameter (inches) 2"
  - (2) total depth (feet) 53'
  - (3) static water level (feet) 30' (below above top of ground)
  - (4) casing (material) steel (depth) 47'
  - (size) 2" if telescope see back.
  - (5) screen (length) 5' (depth to top) 48'
  - (size) 1/4" (material) galv. SS.
  - (6) pump (HP) 1 (yield gpm) 15
  - (type power) elec.
  - (7) electric log (yes or no) no
  - (organization running log)
  - (8) how well bottom plugged Blank cement

5' 14" & shot SS well		
3' 1/4" log sheet in		
with packer		
42" 1/4" drop pipe		

**CODED**


APR 23 1971

DRILLERS REMARKS:

MISS. BD. OF  
WATER COMM.

If well telescopes please sketch and show depths.

GROUND LEVEL

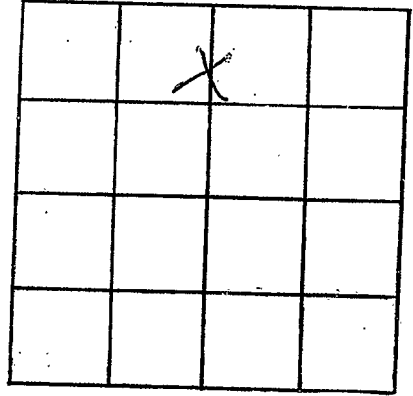

SECTION 22

Please indicate well location X.

ADDITIONAL INFORMATION

If more than one screen, show locations of each on sketch.