

WAYNE

T52

9-18-71

MISSISSIPPI BOARD OF WATER COMMISSIONERS 416 North State Street Jackson, Mississippi 39201

CODED

WATER WELL DRILLERS LOG

Sept 18 1971 Date well completed 21 South Drilling & Log Name firm name Wayne county well located

LANDOWNER: Earnest Muller 211 Buchanan Miss (mailing address)

Table with 3 columns: description of formations encountered, from, to. Rows: sand & chalk (0-53), Chalk (53-75), sand (75-90), sand white shell, sand.

WELL LOCATION: sec 9 T 70 N R 6 S 6 miles S of Wiggins (distance) (direction) (nearest town)

5' 1 1/2" Tubing Sand with 2' 1/2" Pipe first in well by the drill

WELL PURPOSE: Home (home, irrigation, municipal, industrial)

- WELL COMPLETION DATA: (1) diameter (inches) 2" (2) total depth (feet) 90' (3) static water level (feet) 56 below top of ground (4) casing (material) steel (depth) 84' (size) 2" if telescope see back (5) screen (length) 5' (depth to top) 85' (size) 1 1/4" Tubing (material) SS (6) pump 3/4 (HP) 3 1/2 (yield gpm) elec (type power) (7) electric log yes (yes or no) (organization running log) (8) how well bottom plugged

CODED


DRILLERS REMARKS:

OCT 22 1971

MISSISSIPPI WATER COMMISSION

If well telescopes please sketch and show depths.

GROUND LEVEL

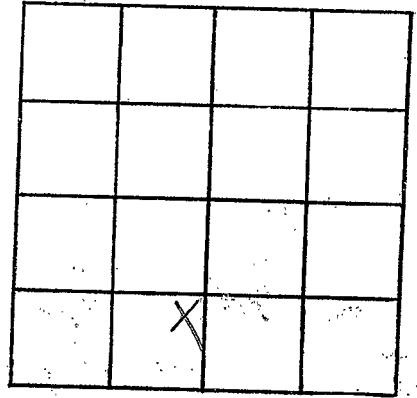

SECTION 9

Please indicate well location X.

ADDITIONAL INFORMATION

Lined area for additional information.

If more than one screen, show locations of each on sketch.