

Wayne
T 53
12-17-71

MISSISSIPPI
BOARD OF WATER COMMISSIONERS
416 North State Street
Jackson, Mississippi 39201

DEC 28 1971

WATER WELL DRILLERS LOG
CODED


Dec 17 1971 date well completed
Porter Drilling & Supply firm name
Wayne county well located

LANDOWNER	description of formations encountered	from	to
James H. Hally			
623 Hargreshoro Minn (mailing address)	Chalk sand & ch. ch. ch. stratified ch. ch.	0	9 60 74
WELL LOCATION: sec. 20 T 70 N R 6 E 6 miles east of Clarks (distance) (direction) (nearest town)			
WELL PURPOSE: home (home, irrigation, municipal, industrial)	screen test in well packer no log pipe		
WELL COMPLETION DATA:	4 9' 1 1/4" ch. pipe		
(1) diameter (inches) 2"			
(2) total depth (feet) 74'			
(3) static water level (feet) 33' below top of ground.			
(4) casing steel 65' (material) (depth) 2" if telescope see back. (size)			
(5) screen 12' 62' (length) (depth to top) 1 1/2" 80 ga SS (size) (material)			
(6) pump 1 8 (HP) (yield gpm) elec. (type power)			
(7) electric log no (yes or no)			
(organization running log)			
(8) how well bottom plugged plugged cement			
DRILLERS REMARKS:			

CODED

If well telescopes please sketch and show depths.

GROUND LEVEL

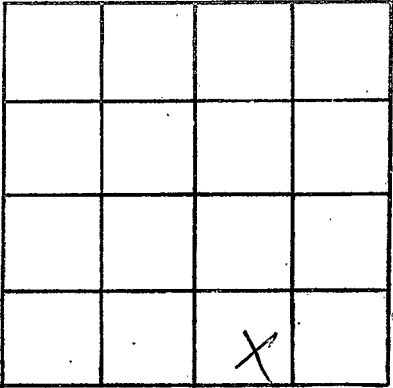

SECTION 20

Please indicate well location X.

ADDITIONAL INFORMATION

A series of 20 horizontal lines provided for writing additional information.

If more than one screen, show locations of each on sketch.