

Wayne
T 55
1-5-72

MISSISSIPPI
BOARD OF WATER COMMISSIONERS
416 North State Street
Jackson, Mississippi 39201

FEB 10 1972

WATER WELL DRILLERS LOG

MISS. BD. OF
WATER COMM

FILED


1-5-1972 date well completed
Risen Water Well Co. firm name
Wayne county well located

LANDOWNER:	description of formations encountered		from	to
J. P. McDonald	Red clay		0	8
R.T. 3 Waynesboro Miss (mailing address)	Blue chalk		8	17
	Thin to coarse sand		17	27
	Total			27'
WELL LOCATION: sec. 12 T 7 N R 6 E 7 miles South of Waynesboro (distance) (direction) (nearest town)				
WELL PURPOSE: Home (home, irrigation, municipal, industrial)				
WELL COMPLETION DATA:				
(1) diameter (inches) 4"				
(2) total depth (feet) 27'				
(3) static water level (feet) 18' below top of ground.				
(4) casing 1 1/4" (material), 24' (depth)				
(size) If telescope see back.				
(5) screen 3' (length), 27' (depth to top)				
1 1/2" Brass lined drive pipe (size) (material)				
(6) pump 1/2 (HP), 8 (yield gpm)				
Electric (type power)				
(7) electric log NO (yes or no)				
(organization running log)				
(8) how well bottom plugged drive - pant				
DRILLERS REMARKS: Good				

FILED

If well telescopes please sketch and show depths.

GROUND LEVEL

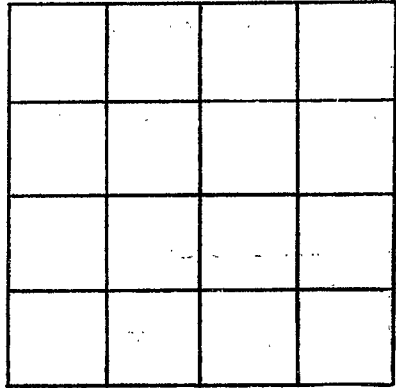

SECTION _____

Please indicate well location X.

ADDITIONAL INFORMATION

If more than one screen,
show locations of each on sketch.