

WAYNE
T 57
5-20-72

MISSISSIPPI
BOARD OF WATER COMMISSIONERS
416 North State Street
Jackson, Mississippi 39201

WATER WELL DRILLERS LOG

CODED


5-20-1972 date well completed
Risen Water Well Serv firm name
Wayne county well located

LANDOWNER:	description of formations encountered	from	to
Charles Mason RT 3 Waynesboro, Miss. (mailing address)	Top soil Red sand Blue clauk Fine sand	0 3 15 35	3 8 35 67
WELL LOCATION: sec. 3 T 70 S R 6 E 7 miles West of Buckatunna (distance) (direction) (nearest town)	Total	67	
WELL PURPOSE: <u>Fount</u> (home, irrigation, municipal, industrial)			
WELL COMPLETION DATA:			
(1) diameter (inches) <u>4"</u>			
(2) total depth (feet) <u>67'</u>			
(3) static water level (feet) <u>35'</u> below above top of ground.			
(4) casing <u>2"</u> <u>64'</u> (material) (depth)	CODED		
_____ if telescope see back. (size)			
(5) screen <u>3'</u> <u>67'</u> (length) (depth to top)			
(6) pump <u>2"</u> <u>Bloss lined</u> (size) (material)			
(7) pump <u>3/4</u> <u>5</u> (HP) (yield gpm)			
<u>Electric</u> (type power)			
(7) electric log <u>no</u> (yes or no)			
_____ (organization running log)			
(8) how well bottom plugged <u>Drive Pipe</u>			
DRILLERS REMARKS: <u>Fair</u>			

JUN 9 1972

If well telescopes please sketch and show depths.

GROUND LEVEL

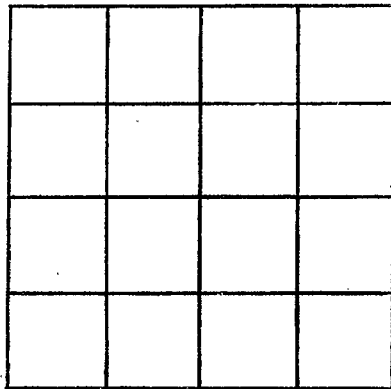

SECTION _____

Please indicate well location X.

ADDITIONAL INFORMATION

Horizontal lines for additional information.

If more than one screen, show locations of each on sketch.