

Wayne  
T 59  
9-2-72

MISSISSIPPI  
BOARD OF WATER COMMISSIONERS  
416 North State Street  
Jackson, Mississippi 39201

**CODED**

WATER WELL DRILLERS LOG

Sept 2 1972 Porter Drilling & Log Wayne  
date well completed firm name county well located

LANDOWNER: Jessie Lee  
David  
214 Wagnersboro Miss  
(mailing address)

description of formations encountered	from	to
red sand	0	22
clay	22	28
med. sand	28	94
sh. med. in clay		
sand		

WELL LOCATION:  
sec. 12 T 70 N R 6 E  
3 miles N of Buckatun  
(distance) (direction) (nearest town)

5' 1/4" 6" shot S.S.

WELL PURPOSE: none  
(home, irrigation, municipal, industrial)

test run with packer

- WELL COMPLETION DATA:
- (1) diameter (inches) 2"
  - (2) total depth (feet) 94'
  - (3) static water level (feet) 65 below top of ground.
  - (4) casing steel, 90'  
(material) (depth)  
2" if telescope see back.  
(size)
  - (5) screen 5', 89'  
(length) (depth to top)  
1/2", 6 shot S.S.  
(size) (material)
  - (6) pump 1, 10  
(HP) (yield gpm)  
elec.  
(type power)
  - (7) electric log no  
(yes or no)
- (organization running log)

84' 1/4" dog pipe

**CODED**

(8) how well bottom plugged  
plug point


DRILLERS REMARKS:

SEP 18 1972

MISSISSIPPI BOARD OF WATER COMMISSIONERS

If well telescopes please sketch and show depths.

GROUND LEVEL

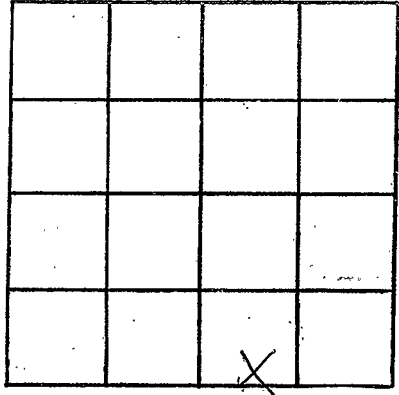

SECTION 12

Please indicate well location X.

ADDITIONAL INFORMATION

If more than one screen, show locations of each on sketch.