

Wayne
T64
10-29-72

MISSISSIPPI
BOARD OF WATER COMMISSIONERS
416 North State
Jackson, Mississippi 39201

CODED

WATER WELL DRILLERS LOG

10-29 1972 CARRS well service WAYNE
date well completed firm name county well located

LANDOWNER: E.C. Douglas
Rt 1 BUCATUNNA
MISS 39322
(mailing address)

WELL LOCATION:
sec. 36 T. 7N S. R. 6E W.
1 miles S.W. of BUCATUNNA
(distance) (direction) (nearest town)

WELL PURPOSE: Fish Pond
(home, irrigation, municipal, industrial)

description of formations encountered	from	to
Top Soil	0	3
Yellow Sand	3	10
Yellow & white Clay	10	18
Med white Sand	18	26
Coarse white Sand	26	45
Blue Marl	45	48
Gravel w/ yellow Clay	48	52
Brown yellow & white Clay	52	65
Fine white sand	65	73
White Clay	73	75
Fine white Sand	75	77
White Clay	77	96
Fine white Sand	96	102
Red limy Clay	102	125
White Clay	125	151
Fine white sand	151	153
White Clay	153	154
Med white Sand	154	170

WELL COMPLETION DATA:

(1) diameter (inches) 4" x 2"

(2) total depth (feet) 170

(3) static water level (feet) 1' ^{below} above top of ground.

(4) casing PVC, 150'
(material) (depth)

(size) if telescope see back.

(5) screen None,
(length) (depth to top)

None,
(size) (material)

(6) pump No 60
(HP) (yield gpm)

None
(type power)

(7) electric log No
(yes or no)

(organization running log)

(8) how well bottom plugged Shale
CATCHER @ 146


CODED

NOV - 7 1972

DRILLERS REMARKS: Still in
sand when quit drilling

If well telescopes please sketch and show depths.

GROUND LEVEL

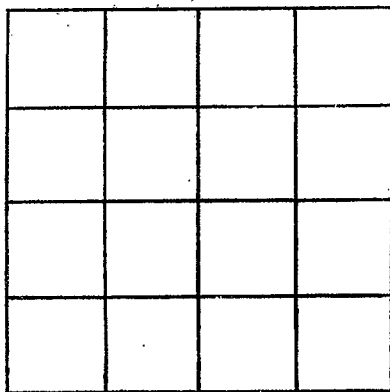

SECTION _____

Please indicate well location X.

ADDITIONAL INFORMATION

If more than one screen, show locations of each on sketch.