

**WAYNE**  
**T 66**  
**3-73**

MISSISSIPPI  
 BOARD OF WATER COMMISSIONERS,  
 416 North State Street  
 Jackson, Mississippi 39201 **CODED**


**WATER WELL DRILLERS LOG**

March 1973 Peoples Drilling Co. Wayne  
 date well completed firm name county well located

LANDOWNER: <u>Fred Allen Poore</u>	description of formations encountered	from	to
<u>RTI Bldg</u>	<u>yellow sandy clay</u>	<u>0</u>	<u>31</u>
<u>Buchatanna, Miss</u> (mailing address)	<u>yellow clay + sand streaks</u>	<u>31</u>	<u>51</u>
<b>WELL LOCATION:</b> sec. <u>27</u> T. <u>7</u> (N) S. R. <u>6</u> E. (W) <u>3</u> miles <u>W</u> of <u>Buchatanna</u> (distance) (direction) (nearest town)	<u>yellow sand</u>	<u>51</u>	<u>93</u>
<b>WELL PURPOSE:</b> <u>Home</u> (home, irrigation, municipal, industrial)			
<b>WELL COMPLETION DATA:</b> (1) diameter (inches) <u>2"</u> (2) total depth (feet) <u>63</u> (3) static water level (feet) <u>53</u> <u>below</u> above top of ground. (4) casing <u>Galv.</u> , <u>58</u> , (material) (depth) <u>2"</u> (size) If telescope see back. (5) screen <u>5'</u> , <u>58</u> (length) (depth to top) <u>2 5/8</u> , <u>stainless steel</u> (size) (material) (6) pump <u>1</u> <u>8</u> (HP) (yield gpm) <u>electric</u> (type power) (7) electric log <u>no</u> (yes or no) _____ (organization running log) (8) how well bottom plugged <u>Back Wash Valve</u>	<b>CODED</b>  <small>WELL 7-2-1973</small>		
<b>DRILLERS REMARKS:</b>			

If well telescopes please sketch and show depths.

GROUND LEVEL

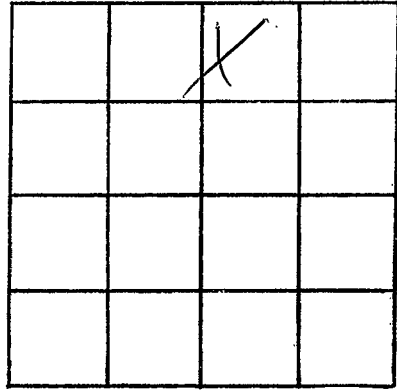

SECTION 27

Please indicate well location X.

ADDITIONAL INFORMATION

If more than one screen, show locations of each on sketch.