

WAYNE
T 70
7-1-79

BOARD OF WATER COMMISSIONERS
416 North State Street
Jackson, Mississippi 39201 CODED
WATER WELL DRILLERS LOG

July 1, 1974 Booth Drilling & Log Wingo
date well completed firm name county well located

LANDOWNER: Paul E. Sweth
214 Magneshboro
(mailing address)

description of formations encountered	from	to
clay + sand	0	18
clay + sand	18	49
clay + sand	49	56
clay + sand	56	57
5 1/4 70 lbs SS. Screen		

WELL LOCATION:
sec. 1 T-70 N 5 R-6 E
(distance) miles (direction) of (nearest town)

WELL PURPOSE: Home
(home, irrigation, municipal, industrial)


- WELL COMPLETION DATA:
- (1) diameter (inches) 2"
 - (2) total depth (feet) 57'
 - (3) static water level (feet) 40' below top of ground.
 - (4) casing PVC (material) 51' (depth)
2" (size) if telescope see back.
 - (5) screen 5' (length) 51' (depth to top)
1 1/4 70 lbs SS (size) (material)
 - (6) pump 1 (HP) 6 (yield gpm)
also (type power)
 - (7) electric log no (yes or no)
 - (organization running log)
 - (8) how well bottom plugged no

DRILLERS REMARKS:

57' 1" PVC casing
screen sand packed
CODED
REGISTRATION
NOV 24 1974
MISS. BD. OF WATER COMMISSIONERS

If well telescopes please
sketch and show depths.

GROUND LEVEL

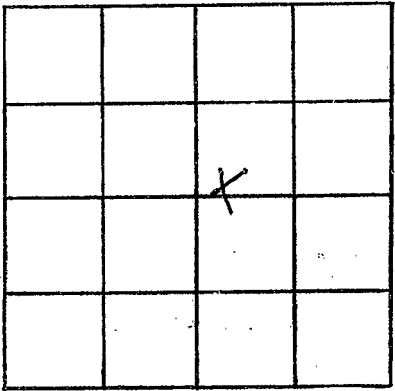

SECTION 1

Please indicate well location X.

ADDITIONAL INFORMATION

A series of horizontal lines for writing additional information.

If more than one screen,
show locations of each on sketch.