

WAYNE
T 71
S-10-74

MISSISSIPPI
BOARD OF WATER COMMISSIONERS
416 North State Street
Jackson, Mississippi 39201

WATER WELL DRILLERS LOG

CODED


May 10 1974 Porter Drilling & Log Wayne
date well completed firm name county well located

LANDOWNER: <u>Procter West</u>	description of formations encountered	from	to
<u>Rt 3 Waynesboro</u> (mailing address)	<u>red clay</u>	<u>0</u>	<u>8</u>
	<u>Chalk</u>	<u>8</u>	<u>65</u>
	<u>fine red sand</u>	<u>25</u>	<u>80</u>
	<u>Unsat coarse sand</u>	<u>80</u>	<u>93</u>
	<u>Chalk</u>	<u>93</u>	<u>95</u>
	<u>Chalky sand</u>	<u>95</u>	<u>109</u>
WELL LOCATION: sec <u>19</u> T <u>71</u> N R <u>6</u> E <u>5</u> miles W of <u>Cuckatur</u> (distance) (direction) (nearest town)			
WELL PURPOSE: <u>domestic</u> (home, irrigation, municipal, industrial)			
WELL COMPLETION DATA:			
(1) diameter (inches) <u>2</u>	<u>5' 1/4" 6 slot ss screen</u>		
(2) total depth (feet) <u>75</u>	<u>on end of casing with</u>		
(3) static water level (feet) <u>52</u> <u>below</u> top of ground. <u>above</u>	<u>back wash valve on end</u>		
(4) casing <u>P.V.C.</u> <u>88'</u> (material) (depth)	<u>and 1/2" stop above</u>		
<u>2"</u> If telescope see back. (size)	<u>65' 1" P.V.C. charge pipe</u>		
(5) screen <u>5'</u> <u>93'</u> (length) (depth to top)			
<u>1/4"</u> <u>6 slot S.S.</u> (size) (material)			
(6) pump <u>1</u> <u>10</u> (HP) (yield gpm)			
<u>elec</u> (type power)			
(7) electric log <u>no</u> (yes or no)			
(organization running log)			
(8) how well bottom plugged <u>1/2" back valve</u>			
DRILLERS REMARKS:			

RECEIVED
JUL 24 1974

If well telescopes please sketch and show depths.

GROUND LEVEL

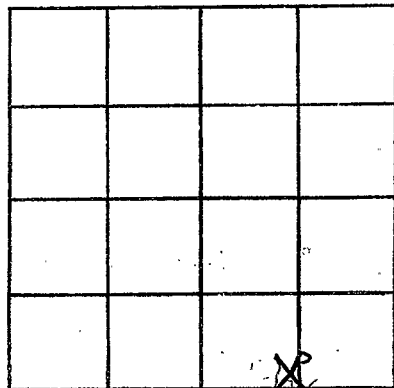

SECTION 19

Please indicate well location X.

ADDITIONAL INFORMATION

If more than one screen,
show locations of each on sketch.