

WAYNE  
T 72  
6-25-74

MISSISSIPPI  
BOARD OF WATER COMMISSIONERS  
416 North State Street  
Jackson, Mississippi 39201

WATER WELL DRILLERS LOG

6-25-74 CARRS well SERV WAYNE  
date well completed firm name county well located


LANDOWNER: Edie Busby  
RT 1 WAYNESBORO MISS.  
(mailing address)  
WELL LOCATION:  
sec. 12 T 7<sup>N</sup> R 6<sup>E</sup>  
S (SW)  
0.8 miles North of BUS  
(distance) (direction) (nearest town)

WELL PURPOSE:  
(home, irrigation, municipal, industrial)

WELL COMPLETION DATA:  
(1) diameter (inches) 2'  
(2) total depth (feet) 120  
(3) static water level (feet) 60 below top of ground.  
(4) casing PVC, 115' (material) (depth)  
(size) if telescope see back.  
(5) screen 5" 115' (length) (depth to top)  
2" PVC (8 slot) (size) (material)  
(6) pump 1 (HP) 6 (yield gpm)  
Elect (type power)  
(7) electric log No (yes or no)  
(organization running log)  
(8) how well bottom plugged 2" SS- Back wash Valve

description of formations encountered	from	to
TOP Soil	0	1
yellow SANDY CLAY	1	8
yellow + pink CLAY	8	14
COARSE white SAND	14	17
white CLAY	17	30
yellow sticky CLAY	30	42
Fine white SAND	42	46
purple-yellow-white Clay	46	60
Blue Clay	60	102
Fine white SAND	102	108
COARSE white SAND	108	112
COARSE yellow SAND	112	115
COARSE white SAND	115	120

CODED

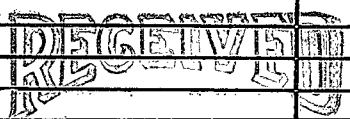


JUL 23 1974

DRILLERS REMARKS: Still in sand when quit felt top!

If well telescopes please sketch and show depths.

GROUND LEVEL

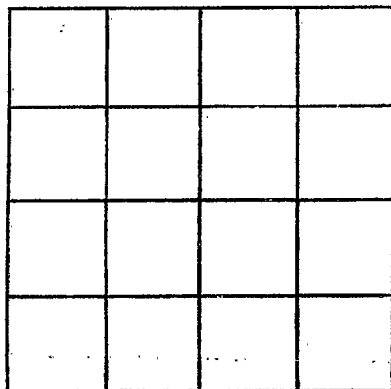

SECTION \_\_\_\_\_

Please indicate well location X.

ADDITIONAL INFORMATION

If more than one screen, show locations of each on sketch.