

WAYNE  
T 73  
S-8-74

MISSISSIPPI  
BOARD OF WATER COMMISSIONERS  
416 North State Street  
Jackson, Mississippi 39201

CODED

WATER WELL DRILLERS LOG

May 8 1974 date well completed  
Denton Drilling Co. firm name  
Wayne county well located

LANDOWNER: Leel Blaney

description of formations encountered from to

611 Buckatunna  
(mailing address)

clay	0	9
sand	9	24
chalk	24	60
sand	60	135
chalk	135	140
thin rock	140	141
chalk	141	150
sand	150	202
chalk	202	230
sand	230	240
chalk	240	255
rock strata	255	295
sand	295	300
chalk	300	392
water bearing	392	450

WELL LOCATION:  
sec 24 T 73 N R 6 E  
1 1/2 miles NW Buckatunna  
(distance) (direction) (nearest town)

WELL PURPOSE: Home  
(home, irrigation, municipal, industrial)

WELL COMPLETION DATA:


- (1) diameter (inches) 2
- (2) total depth (feet) 450
- (3) static water level (feet) 392 below above  
top of ground.
- (4) casing steel 392  
(material) (depth)  
2 if telescope see back.  
(size)
- (5) screen iron insert  
(length) (depth to top)  
(size) (material)
- (6) pump 5  
(HP) (yield gpm)  
flow  
(type power)
- (7) electric log no  
(yes or no)

(organization running log)

(8) how well bottom plugged open


DRILLERS REMARKS:

CODED

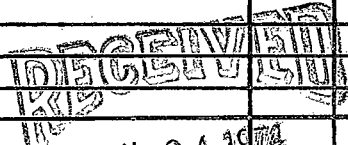

If well telescopes please  
sketch and show depths.

GROUND LEVEL

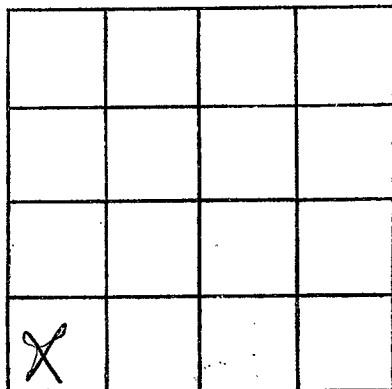

SECTION 274

Please indicate well location X.

ADDITIONAL INFORMATION

If more than one screen,  
show locations of each on sketch.