

WAYNE
T 74
7-12-74

MISSISSIPPI
 BOARD OF WATER COMMISSIONERS
 416 North State Street
 Jackson, Mississippi 39201

CODED

WATER WELL DRILLERS LOG

McILWAIN WATER WELL SERVICE **WAYNE**

July 12, 1974
 date well completed

RT. 2 BOX 37

county well located

WAYNESBORO, MISS. 39367

LANDOWNER:
 Ollie Davis
 WAYNESBORO, Miss.
 (mailing address)

WELL LOCATION:
 sec. 12 T 7 N R 6 E
 8 miles SE of W'BORO
 (distance) (direction) (nearest town)

WELL PURPOSE: HOME
 (home, irrigation, municipal, industrial)

description of formations encountered	from	to
Sand	0	5
Clay	5	9
Sand	9	20
Coarse Sand & gravel	20	31

WELL COMPLETION DATA:

(1) diameter (inches) 2"

(2) total depth (feet) 31'

(3) static water level (feet) 18' below top of ground.

(4) casing PVC, 26' (material) (depth)
 2" (size) if telescope see back.

(5) screen 5' (length), 26' (depth to top)
 2" (size), PVC .008 (material)

(6) pump 3/4 (HP), 12 (yield gpm)
 110 AC (type power)

(7) electric log no (yes or no)
 (organization running log)

(8) how well bottom plugged

CODED


RECEIVED
 MISS. BOARD OF WATER COMMISSIONERS
 AUG 13 1974

MISS. BD. OF WATER COMMISSIONERS

DRILLERS REMARKS:

If well telescopes please sketch and show depths.

GROUND LEVEL

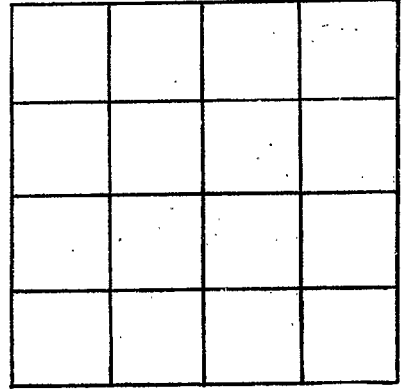

SECTION _____

Please indicate well location X.

ADDITIONAL INFORMATION

If more than one screen, show locations of each on sketch.