

WAYNE
T 75
7-6-74

MISSISSIPPI
BOARD OF WATER COMMISSIONERS
416 North State Street
Jackson, Mississippi 39201

CODED

WATER WELL DRILLERS LOG

July 6 1974 Porter Drilling Wayne
date well completed firm name county well located

LANDOWNER: Solomon
Markburn
At 1 Buckatuna
(mailing address)


description of formations encountered	from	to
clay & chalk	0	22
red sand	22	36
red chalk	36	30
blue chalk	30	199
sand	199	232
stop on chalk		

WELL LOCATION:
sec 27 T 70 N R 6 E
3 miles W of Buckatuna
(distance) (direction) (nearest town)

WELL PURPOSE: none
(home, irrigation, municipal, industrial)

WELL COMPLETION DATA:
(1) diameter (inches) 2
(2) total depth (feet) 232
(3) static water level (feet) 100 below top of ground.
(4) casing P.V.C. 217' (material) (depth)
2' if telescope see back. (size)
(5) screen 5' 217' (length) (depth to top)
1 1/4" 6 slt SS. (size) (material)
(6) pump 1 1/2 (HP) 1 (yield gpm)
elec (type power)
(7) electric log no (yes or no)
(organization running log)
(8) how well bottom plugged back wash valve


5' 1 1/4' b slt SS with back wash valve on end and shell top above
120' 1" P.V.C. dry pipe

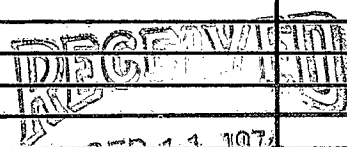

SEP 11 1974

If well telescopes please sketch and show depths.

GROUND LEVEL

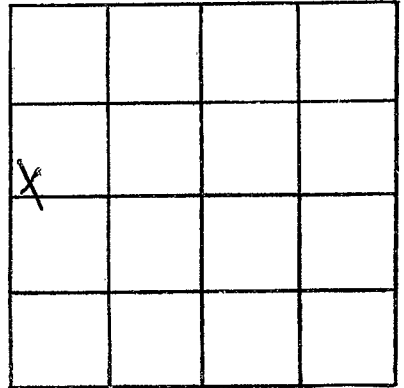

SECTION 22

Please indicate well location X.

ADDITIONAL INFORMATION

If more than one screen,
show locations of each on sketch.