

**MISSISSIPPI
BOARD OF WATER COMMISSIONERS**
416 North State Street
Jackson, Mississippi 39201

CODED

WATER WELL DRILLERS LOG

WAYNE
T 76
R-7-74

July 7 1974 Boyle Drilling Wayne
date well completed firm name county well located

LANDOWNER: Edy Singler

description of formations encountered	from	to
---------------------------------------	------	----

214 Waynesboro
(mailing address)

clg.	0	8
sand	8	21
sandy chert	21	24
chert	24	32
chert	32	55
sand	55	80

WELL LOCATION:
sec. 1 T. 70 N. R. 6 E. W. 5
5 miles N of Purchas
(distance) (direction) (nearest town)

at point on chert

WELL PURPOSE: domestic
(home, irrigation, municipal, industrial)

WELL COMPLETION DATA:

- (1) diameter (inches) 2 1/2
- (2) total depth (feet) 80
- (3) static water level (feet) 76 1/2 (below top of ground. above)
- (4) casing PVC, 76' (material) (depth)
2" If telescope see back. (size)
- (5) screen 4', 76' (length) (depth to top)
1/4", 76' (size) (material) 76' 1/4" P.V.C drop
- (6) pump 1/2 8 1/2 (HP) (yield gpm)
elec. (type power)
- (7) electric log no (yes or no)

4' 1 1/2" 76' chert ss
reversed on end of
casings with back
was made on end
and still drop above
pipe

(organization running log)

(8) how well bottom plugged backwash valve


DRILLERS REMARKS:

RECEIVED
SEP 11 1974

MISS. BD. OF WATER COMMISSIONERS

If well telescopes please sketch and show depths.

GROUND LEVEL

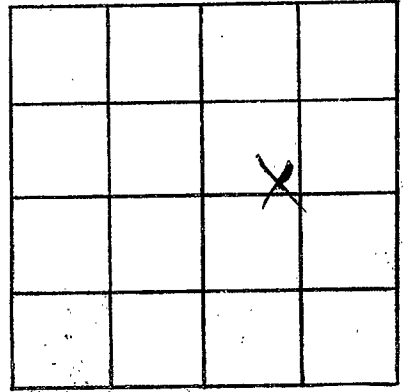

SECTION 1

Please indicate well location X.

ADDITIONAL INFORMATION

If more than one screen, show locations of each on sketch.